



**MAX WATTERSON  
+ASSOCIATES**

**CONSULTING SURVEYORS  
& PLANNERS**

12 Maple Street  
PO Box 639  
Cooroy Qld 45  
Ph. (07) 54426121  
Fax. (07) 54425125  
Email. office@mwasurveys.com.au

Client: **PEET.**

Project:  
**PLAN SHOWING  
SEWER & WATER  
AS-CONSTRUCTED  
DETAILS AT STAGE 3  
GREENWOOD  
GROVE ESTATE  
COOROY.**


PARISH: TEWANTIN  
COUNTY: MARCH  
LOCAL GOVT: SUNSHINE COAST R.C.  
LOCALITY: COOROY

Scale: 1:600  
Datum: AHD  
Origin: PM 177748  
RL 114.594  
Cont.Int:

Plan 1 of 2  
Date: 30-03-11


Ref:  
**97-619ST3ACa1**

NOTE:  
LOCATION OF WATER MAIN & INVERT  
LEVELS OF SEWER SUPPLIED BY  
SHADFORTH'S CIVIL CONTRACTORS.

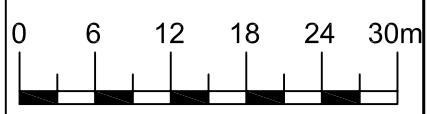

I Max Watterson, being a Consulting Surveyor registered with the Surveyors Board of Qld hereby,  
- certify the information contained in this drawing is an accurate "as constructed"  
representation of the works.  
- accept responsibility for the "as constructed" information contained in this drawing.  
- acknowledge the "as constructed" information in the drawing may be relied on by Council  
and others.  
Certification for Stage 3 by \_\_\_\_\_ on \_\_\_\_\_ Registered Surveyor No. S1788.

**ENGINEERS CERTIFICATION**  
WE AS CONSULTING ENGINEERS, HEREBY CERTIFY THE INFORMATION  
CONTAINED ON THIS DRAWING IS AN ACCURATE TRANSCRIPTION OF THE  
'AS CONSTRUCTED' SURVEY PROVIDED AND ACKNOWLEDGE THE  
'AS CONSTRUCTED' INFORMATION CONTAINED IN THE DRAWING MAY  
BE RELIED ON BY COUNCIL AND OTHERS.  
DATED..... FOR..... RPEQ .....

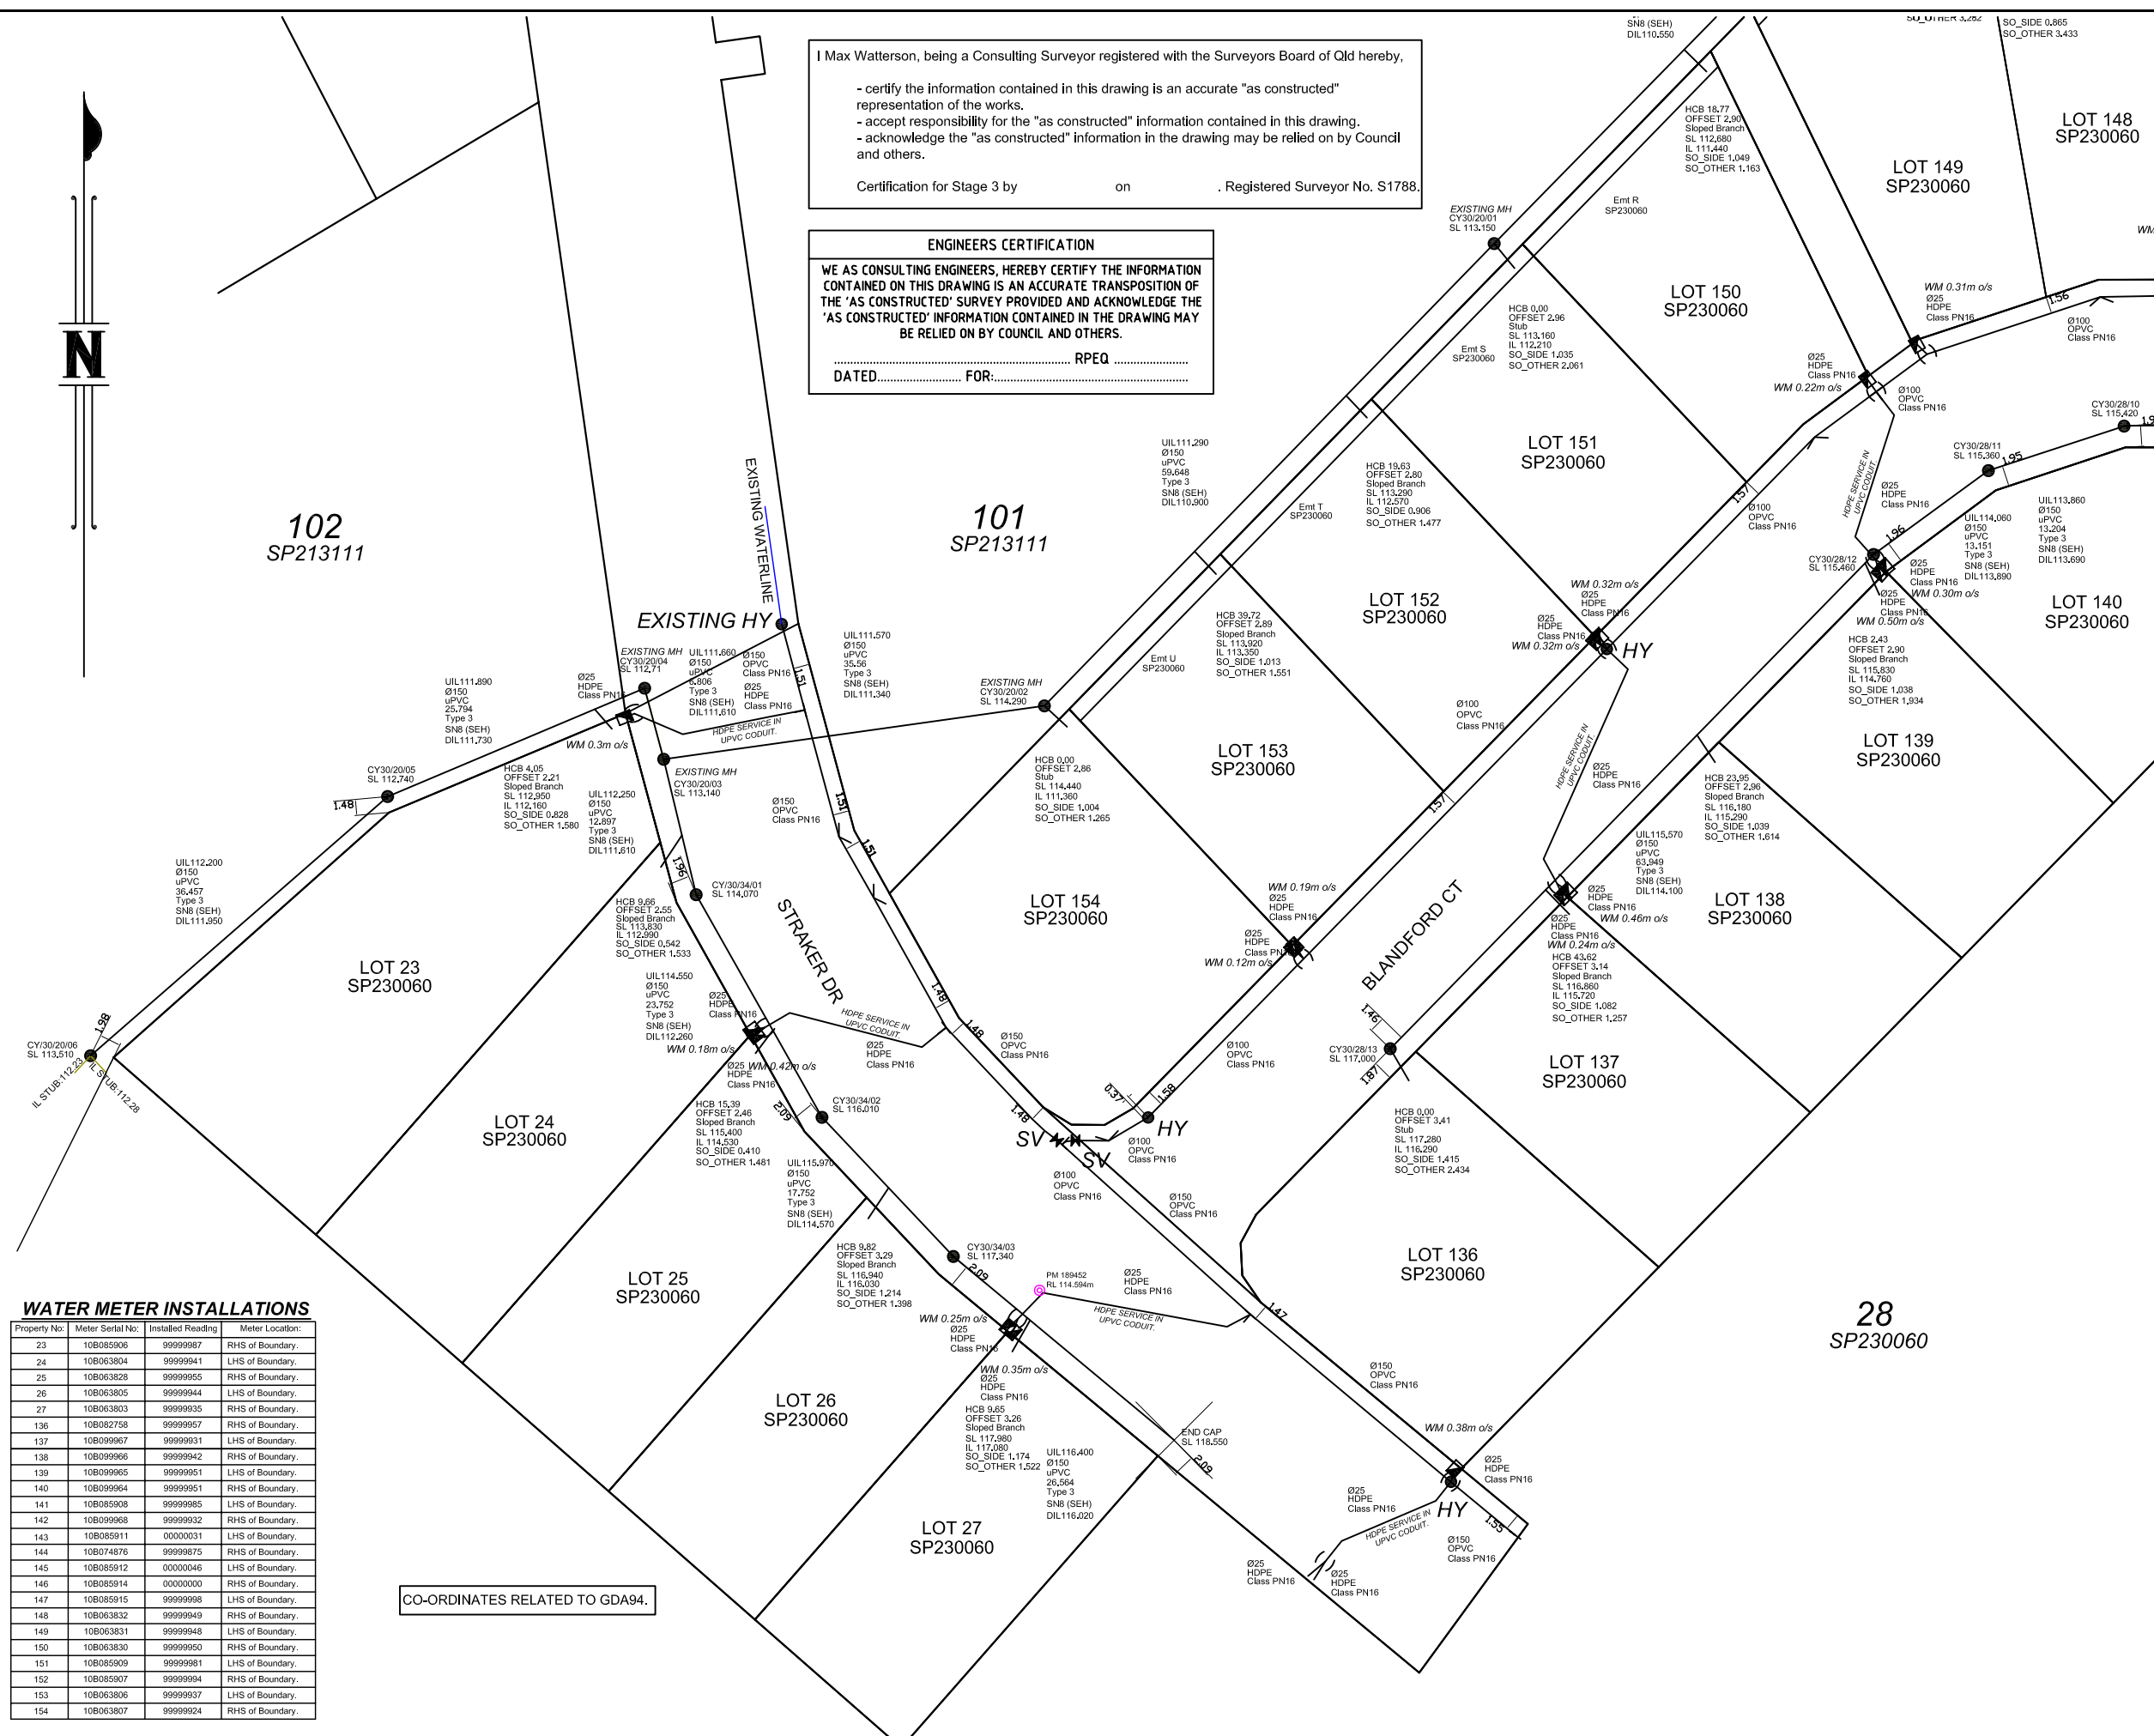

**WATER METER INSTALLATIONS**

Property No.	Meter Serial No.	Installed Reading	Meter Location:
23	10B085906	99999987	RHS of Boundary.
24	10B063804	99999941	LHS of Boundary.
25	10B063828	99999955	RHS of Boundary.
26	10B063805	99999944	LHS of Boundary.
27	10B063803	99999935	RHS of Boundary.
136	10B082758	99999957	RHS of Boundary.
137	10B099967	99999931	LHS of Boundary.
138	10B099966	99999942	RHS of Boundary.
139	10B099965	99999951	LHS of Boundary.
140	10B099964	99999951	RHS of Boundary.
141	10B085908	99999985	LHS of Boundary.
142	10B099968	99999932	RHS of Boundary.
143	10B085911	00000031	LHS of Boundary.
144	10B074876	99999975	RHS of Boundary.
145	10B085912	00000046	LHS of Boundary.
146	10B085914	00000000	RHS of Boundary.
147	10B085915	99999998	LHS of Boundary.
148	10B063832	99999949	RHS of Boundary.
149	10B063831	99999948	LHS of Boundary.
150	10B063830	99999950	RHS of Boundary.
151	10B085909	99999981	LHS of Boundary.
152	10B085907	99999994	RHS of Boundary.
153	10B063806	99999937	LHS of Boundary.
154	10B063807	99999924	RHS of Boundary.

CO-ORDINATES RELATED TO GDA94.



**MAX WATTERSON  
+ASSOCIATES**

**CONSULTING SURVEYORS  
& PLANNERS**

12 Maple Street  
PO Box 639  
Cooroy Qld 45  
Ph. (07) 54426121  
Fax. (07) 54425125  
Email. office@mwasurveys.com.au

Client: **PEET.**

Project:  
**PLAN SHOWING  
SEWER & WATER  
AS-CONSTRUCTED  
DETAILS AT STAGE 3  
GREENWOOD  
GROVE ESTATE  
COOROY.**

PARISH: TEWANTIN  
COUNTY: MARCH  
LOCAL GOVT: SUNSHINE COAST R.C.  
LOCALITY: COOROY

Scale: 1:750

Datum: AHD

Origin: PM 177748  
RL 114.594

Cont.Int:



Plan 2 of 2

Date: 30-03-11

Ref:  
**97-619ST3ACa2**

NOTE:

LOCATION OF WATER MAIN & INVERT  
LEVELS OF SEWER SUPPLIED BY  
SHADFORTH'S CIVIL CONTRACTORS.

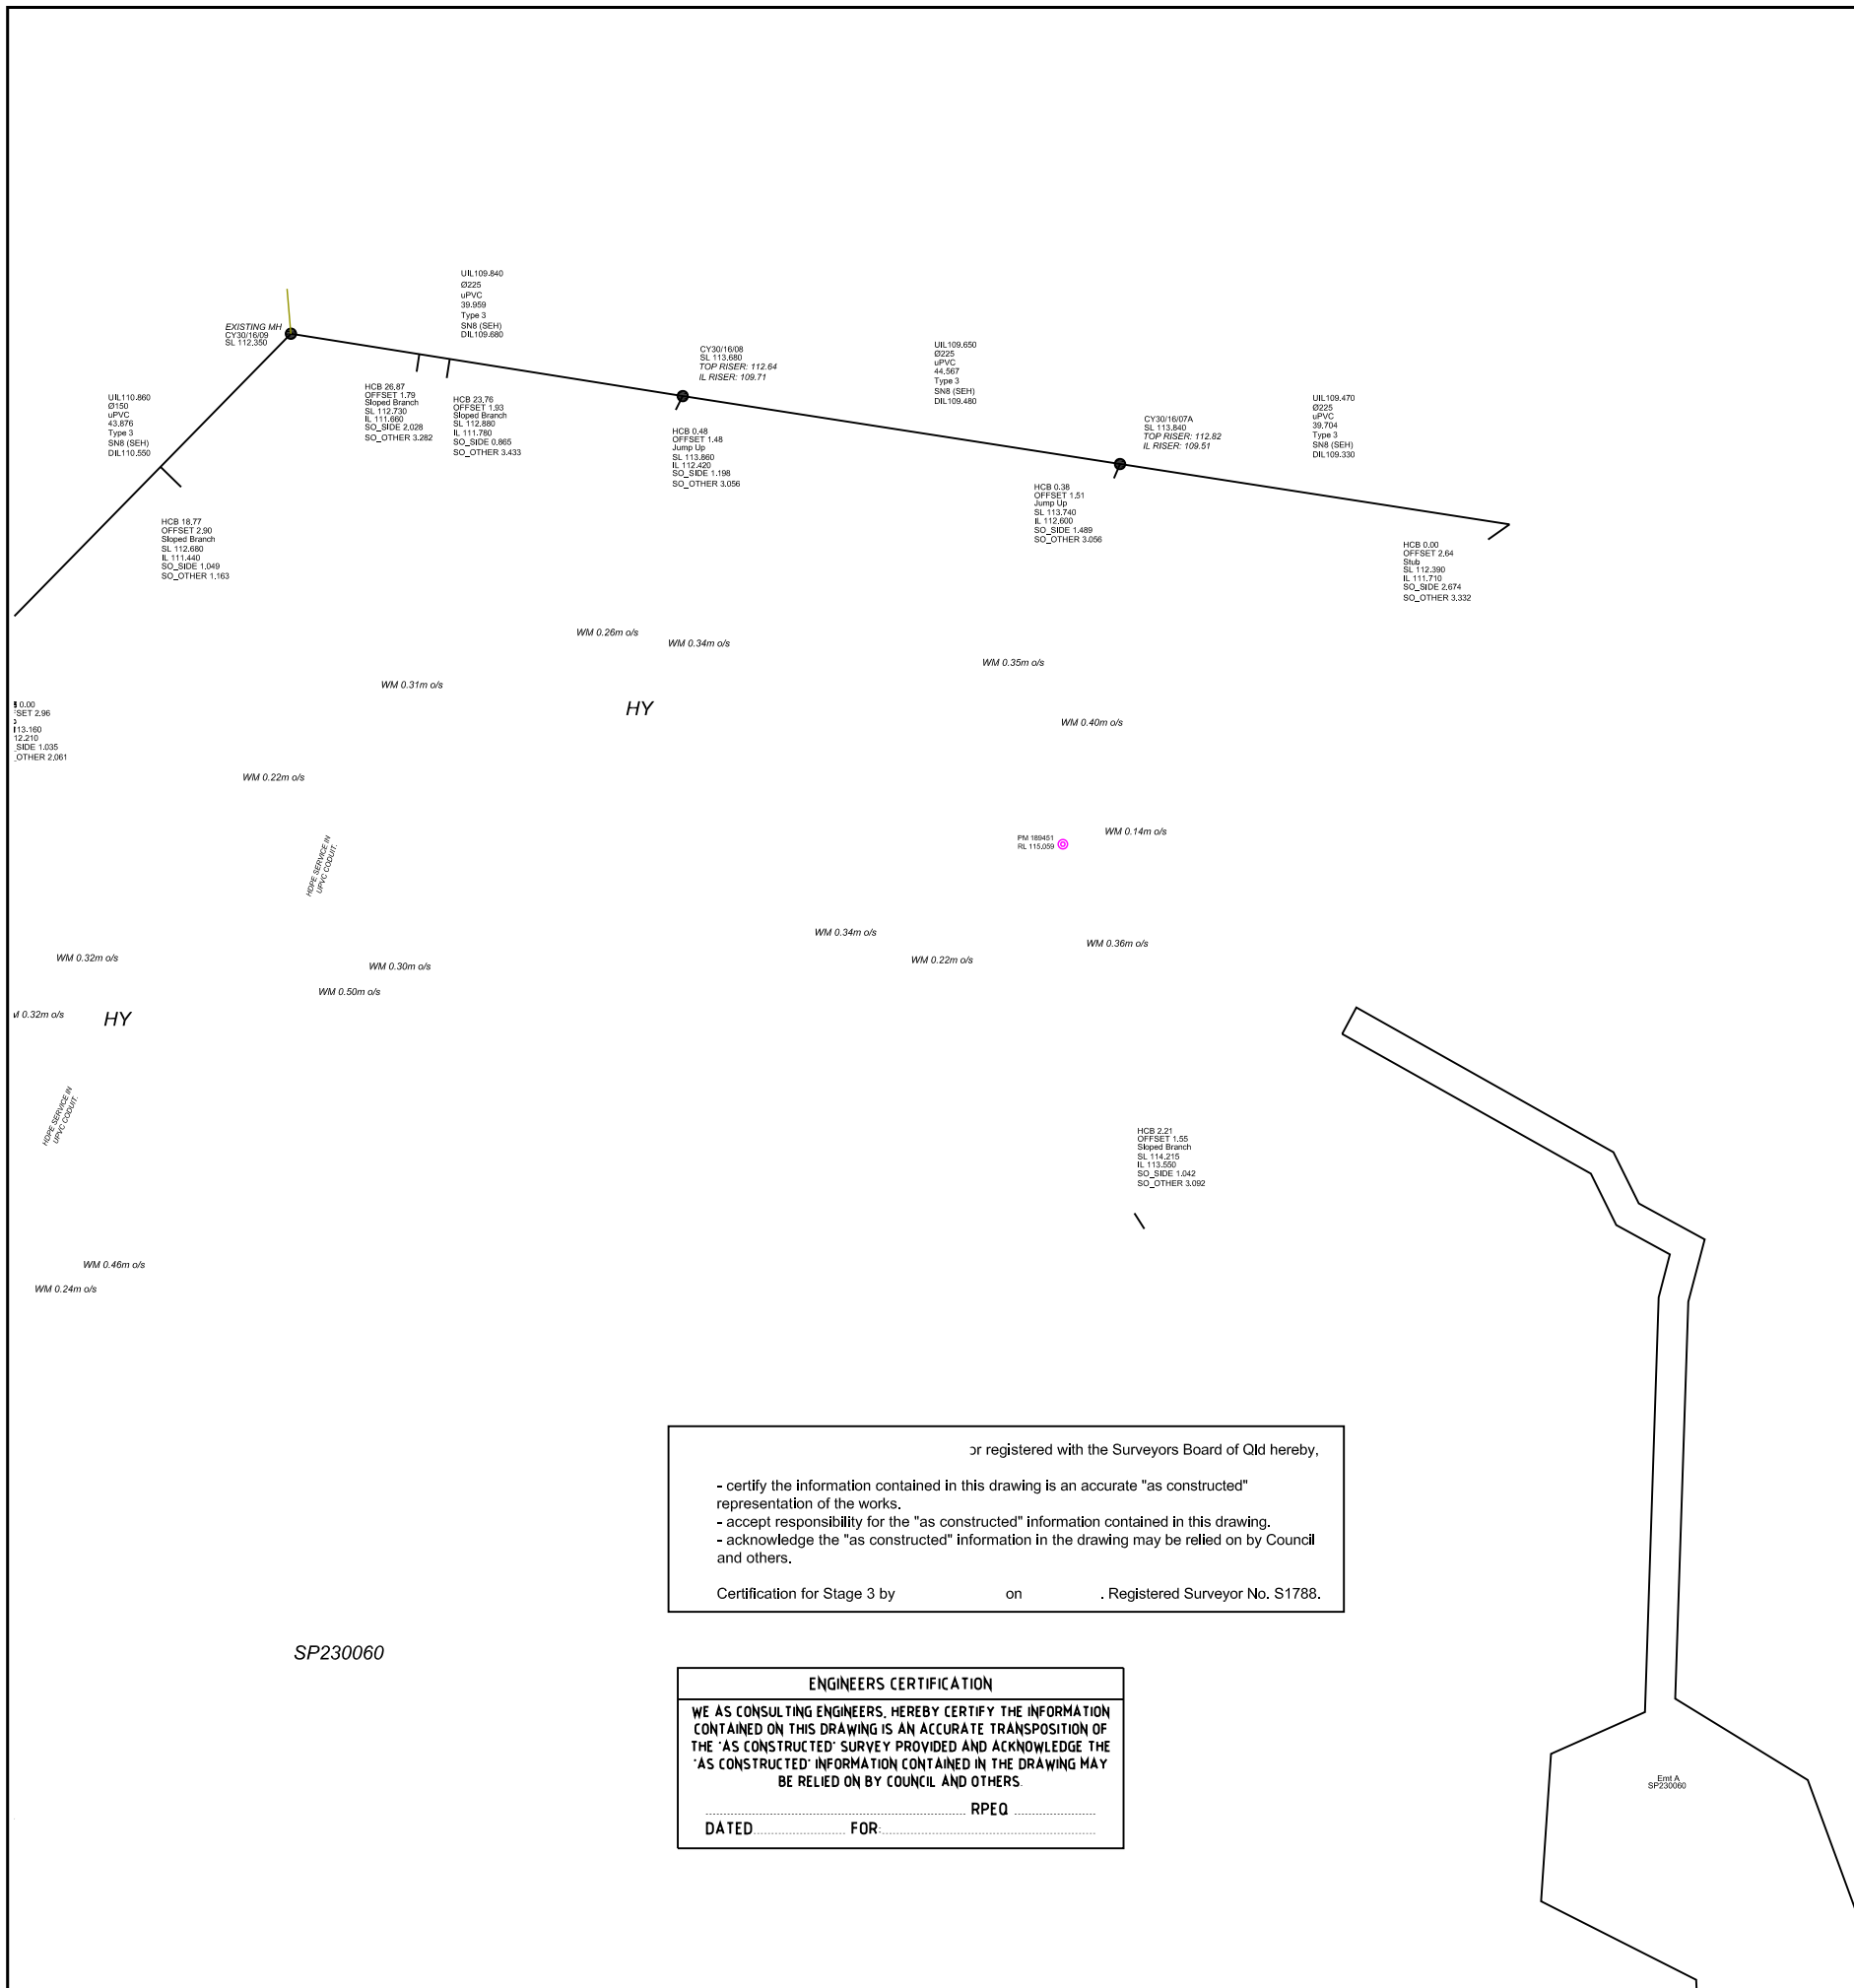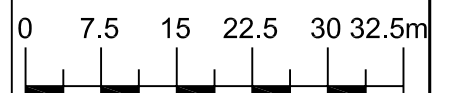

**WATER METER INSTALLATIONS**

Property No:	Meter Serial No:	Installed Reading	Meter Location:
23	10B085906	99999987	RHS of Boundary.
24	10B063804	99999941	LHS of Boundary.
25	10B063828	99999955	RHS of Boundary.
26	10B063805	99999944	LHS of Boundary.
27	10B063803	99999935	RHS of Boundary.
136	10B082758	99999957	RHS of Boundary.
137	10B099967	99999931	LHS of Boundary.
138	10B099966	99999942	RHS of Boundary.
139	10B099965	99999951	LHS of Boundary.
140	10B099964	99999951	RHS of Boundary.
141	10B085906	99999985	LHS of Boundary.
142	10B099968	99999932	RHS of Boundary.
143	10B085911	00000031	LHS of Boundary.
144	10B074876	99999875	RHS of Boundary.
145	10B085912	00000046	LHS of Boundary.
146	10B085914	00000000	RHS of Boundary.
147	10B085915	99999998	LHS of Boundary.
148	10B063832	99999949	RHS of Boundary.
149	10B063831	99999948	LHS of Boundary.
150	10B063830	99999950	RHS of Boundary.
151	10B085909	99999981	LHS of Boundary.
152	10B085907	99999984	RHS of Boundary.
153	10B063806	99999937	LHS of Boundary.
154	10B063807	99999924	RHS of Boundary.

CO-ORDINATES RELATED TO GDA94.

or registered with the Surveyors Board of Qld hereby,  
- certify the information contained in this drawing is an accurate "as constructed" representation of the works.  
- accept responsibility for the "as constructed" information contained in this drawing.  
- acknowledge the "as constructed" information in the drawing may be relied on by Council and others.  
Certification for Stage 3 by \_\_\_\_\_ on \_\_\_\_\_ . Registered Surveyor No. S1788.

**ENGINEERS CERTIFICATION**  
WE AS CONSULTING ENGINEERS, HEREBY CERTIFY THE INFORMATION CONTAINED ON THIS DRAWING IS AN ACCURATE TRANSCRIPTION OF THE 'AS CONSTRUCTED' SURVEY PROVIDED AND ACKNOWLEDGE THE 'AS CONSTRUCTED' INFORMATION CONTAINED IN THE DRAWING MAY BE RELIED ON BY COUNCIL AND OTHERS.  
DATED \_\_\_\_\_ FOR \_\_\_\_\_ RPEQ \_\_\_\_\_

SP230060