


I, CHRIS GREEN
 HEREBY CERTIFY THE "AS CONSTRUCTED"
 DETAILS SHOWN ON THIS PLAN ARE A TRUE
 AND ACCURATE RECORD OF THE WORKS.
 SIGNATURE  RPEQ No 8777
 DATE 05-11-2008
 FOR AND ON BEHALF OF
 WORLEYPARSONS SERVICES PTY. LTD.



AS-BUILT

SURVEYED:- MAX WATTERSON
 P.O. BOX 639
 COOROY QLD 4563
 CONSTRUCTED:- 30/06/08



X:\14-Civil\070015-006 Cooroy Greenwood Grove Stages 1 & 2 As Constructed\Greenwood Grove_Cooroy Stage 1 & 2_ADIAC_R&D.dwg 2008-11-06

A1 SHEET SCALE: 1:1000

OneWay
to zero losses



WorleyParsons
resources & energy

PEET

GREENWOOD GROVE
 GARNET STREET, COOROY - STAGES 1 AND 2
 AS CONSTRUCTED ROADS & DRAINAGE
 SHEET 1 OF 4

COORDINATES IN METRES AND
 ELEVATIONS IN METRES AND
 DIMENSIONS IN MILLIMETRES UNO

WORLEYPARSONS PROJECT NO: 070015-001

DRAWING NO: 1-070015-300

REV: 0

REV	DATE	REVISION DESCRIPTION	ORIG	CKD	ENG	QA	APPD	REF DRG NO	REFERENCE DRAWING TITLE
0	22-10-2008	AS CONSTRUCTED	JP		CG				




I, CHRIS GREEN
 HEREBY CERTIFY THE "AS CONSTRUCTED"
 DETAILS SHOWN ON THIS PLAN ARE A TRUE
 AND ACCURATE RECORD OF THE WORKS.
 SIGNATURE _____ RPEQ No 8777
 DATE 05-11-2008
 FOR AND ON BEHALF OF
 WORLEYPARSONS SERVICES PTY. LTD.

AS-BUILT

SURVEYED:- MAX WATTERSON
 P.O. BOX 639
 COOROY QLD 4563
 CONSTRUCTED:- 30/08/08

GARNET STREET

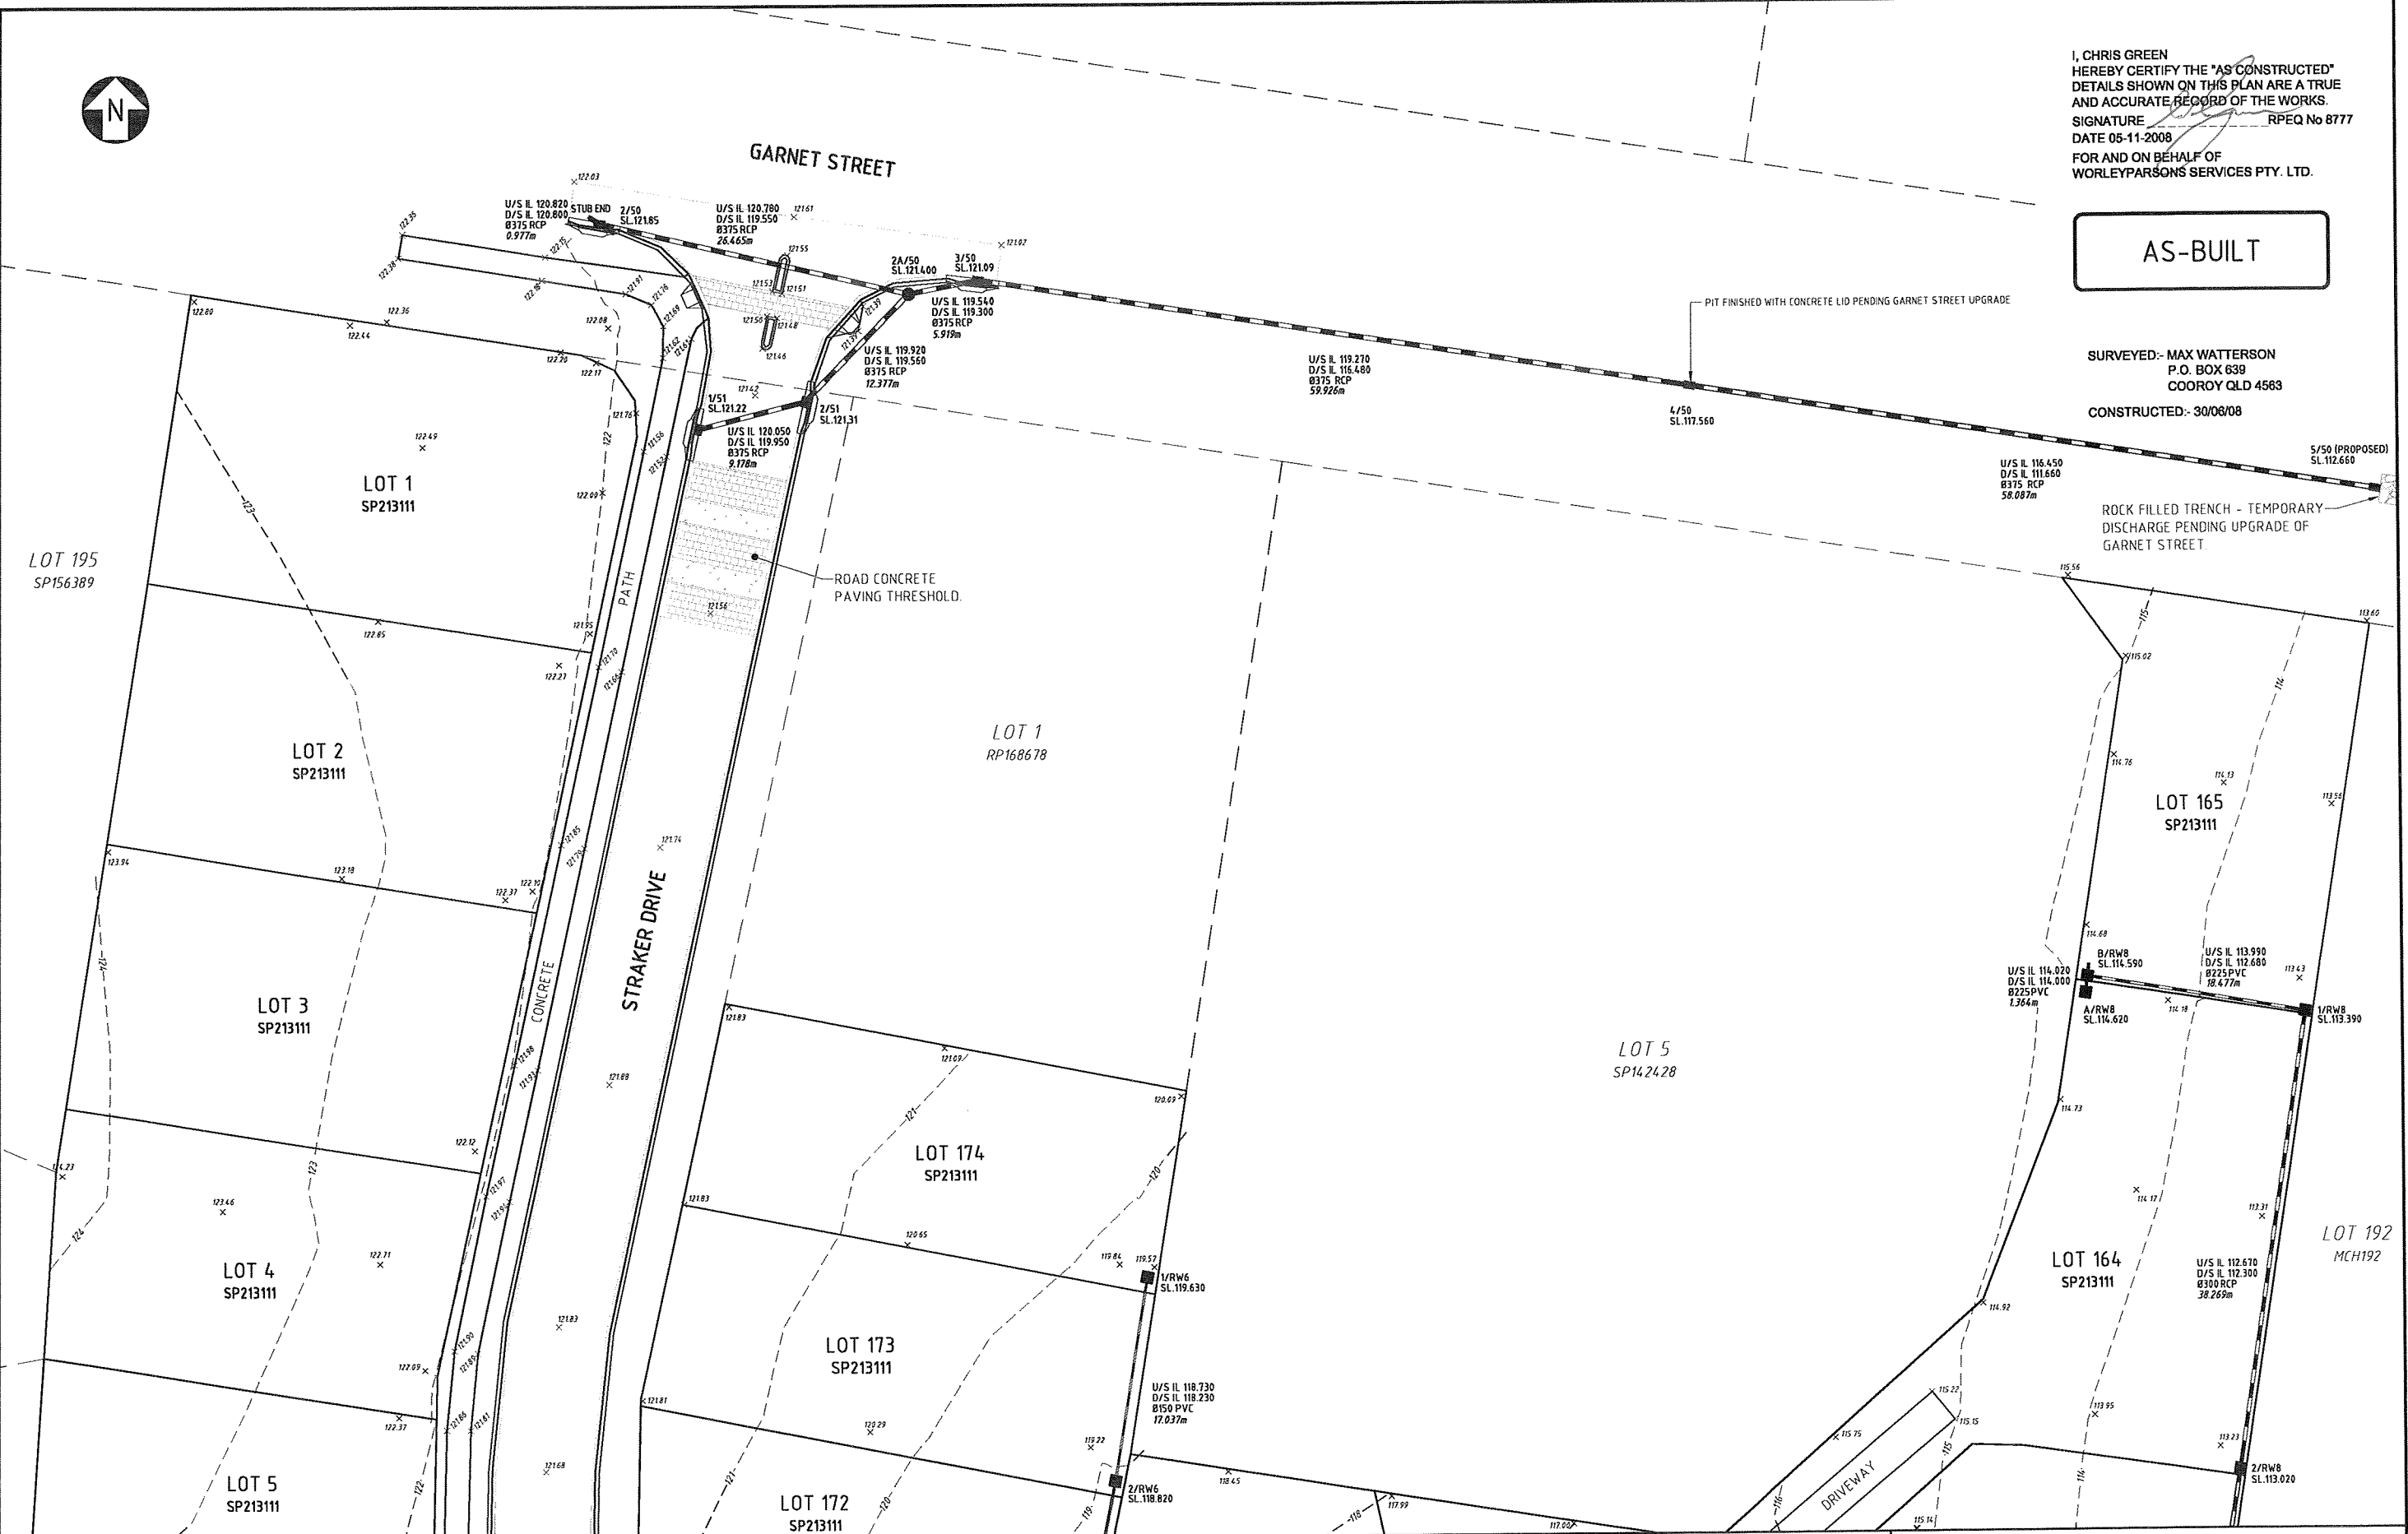

X:\14-Civil\070015-006 Coorooy - Greenwood Grove Stages 1 & 2\As Constructed\Greenwood Grove - Coorooy - Stage 1 & 2 - ADAL R&D.dwg, 2008-11-06
 Copyright © 2008 WorleyParsons Pty Ltd
 AS/NZS 1101:2007


REV	DATE	REVISION DESCRIPTION	ORIG	CKD	ENG	QA	APPD	REF DRG NO	REFERENCE DRAWING TITLE
0	22-10-2008	AS CONSTRUCTED	JP		CG				

A1 SHEET SCALE: 1:250
Oneway
to zero meters
 COORDINATES IN METRES UNO
 ELEVATIONS IN METRES UNO
 DIMENSIONS IN MILLIMETRES UNO

WorleyParsons
 resources & energy
 WORLEYPARSONS PROJECT NO: 070015-001

PREPARED FOR:
PEET

GREENWOOD GROVE
 GARNET STREET, COOROY - STAGES 1 AND 2
 AS CONSTRUCTED ROADS & DRAINAGE
 SHEET 2 OF 4
 DRAWING NO: 1-070015-301
 REV: 0

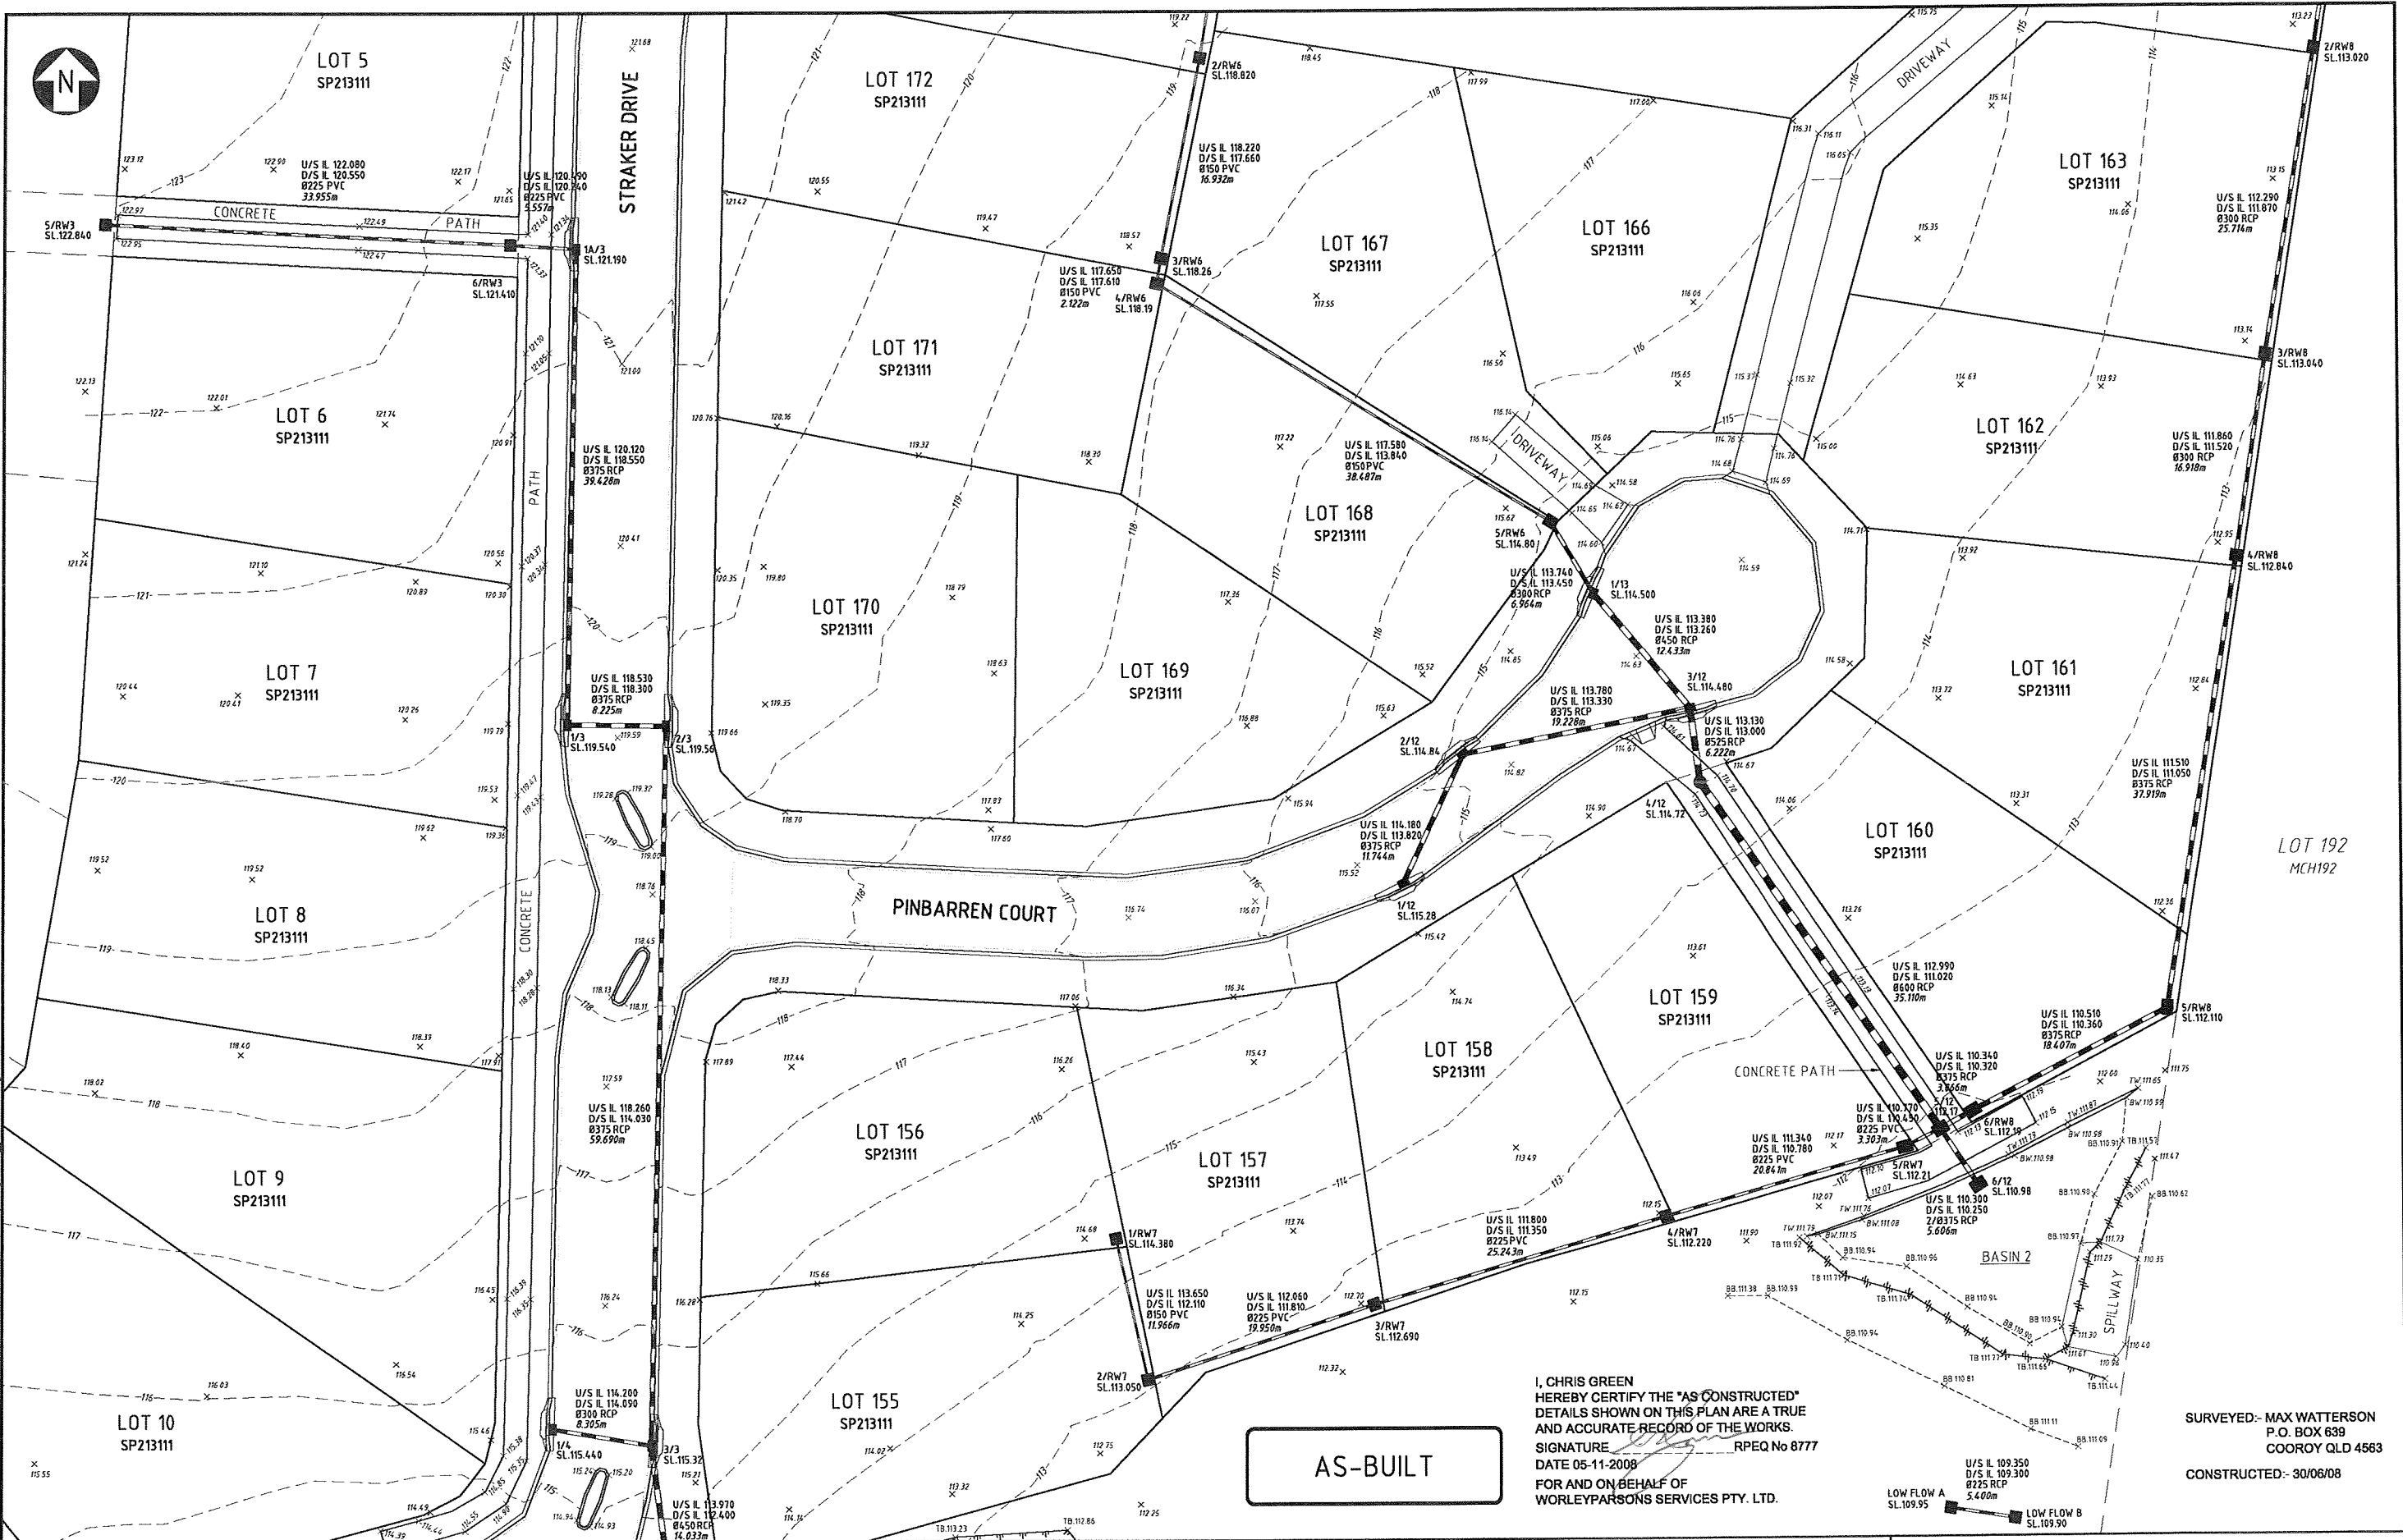

AS-BUILT

I, CHRIS GREEN
HEREBY CERTIFY THE "AS CONSTRUCTED"
DETAILS SHOWN ON THIS PLAN ARE A TRUE
AND ACCURATE RECORD OF THE WORKS.
SIGNATURE: [Signature] RPEQ No 8777
DATE 05-11-2008
FOR AND ON BEHALF OF
WORLEYPARSONS SERVICES PTY. LTD.

SURVEYED:- MAX WATTERSON
P.O. BOX 639
COOROY QLD 4563
CONSTRUCTED:- 30/06/08

REV	DATE	REVISION DESCRIPTION	ORIG	CKD	ENG	QA	APPD	REF DRG NO	REFERENCE DRAWING TITLE
0	22-10-2008	AS CONSTRUCTED	JP	CG					

A1 SHEET SCALE: 1:250
Oneway
COORDINATES IN METRES UNO
ELEVATIONS IN METRES UNO
DIMENSIONS IN MILLIMETRES UNO

WorleyParsons
resources & energy

PREPARED FOR:
PEET

GREENWOOD GROVE
GARNET STREET, COOROY - STAGES 1 AND 2
AS CONSTRUCTED ROADS & DRAINAGE
SHEET 3 OF 4
DRAWING NO: 1-070015-302
REV: 0

X:\14-Chris\1470015-006 Corrooy Greenwood Grove Stages 1 & 2\As Constructed\Greenwood Grove Corrooy Stage 1 & 2_A04C R&D.dwg 2008-11-06

