SURVEYED:- MAX WATTERSON
P.O. BOX 639
COOROY QLD 4563

CONSTRUCTED:- 30/06/08

I, CHRIS GREEN
HEREBY CERTIFY THE "AS CONSTRUCTED"
DETAILS SHOWN ON THIS PLAN ARE A TRUE
AND ACCURATE RECORD OF THE WORKS.
SIGNATURE _____ RPEQ No 8777
DATE 10-10-2008
FOR AND ON BEHALF OF
WORLEYPARSONS SERVICES PTY. LTD.

AS-BUILT

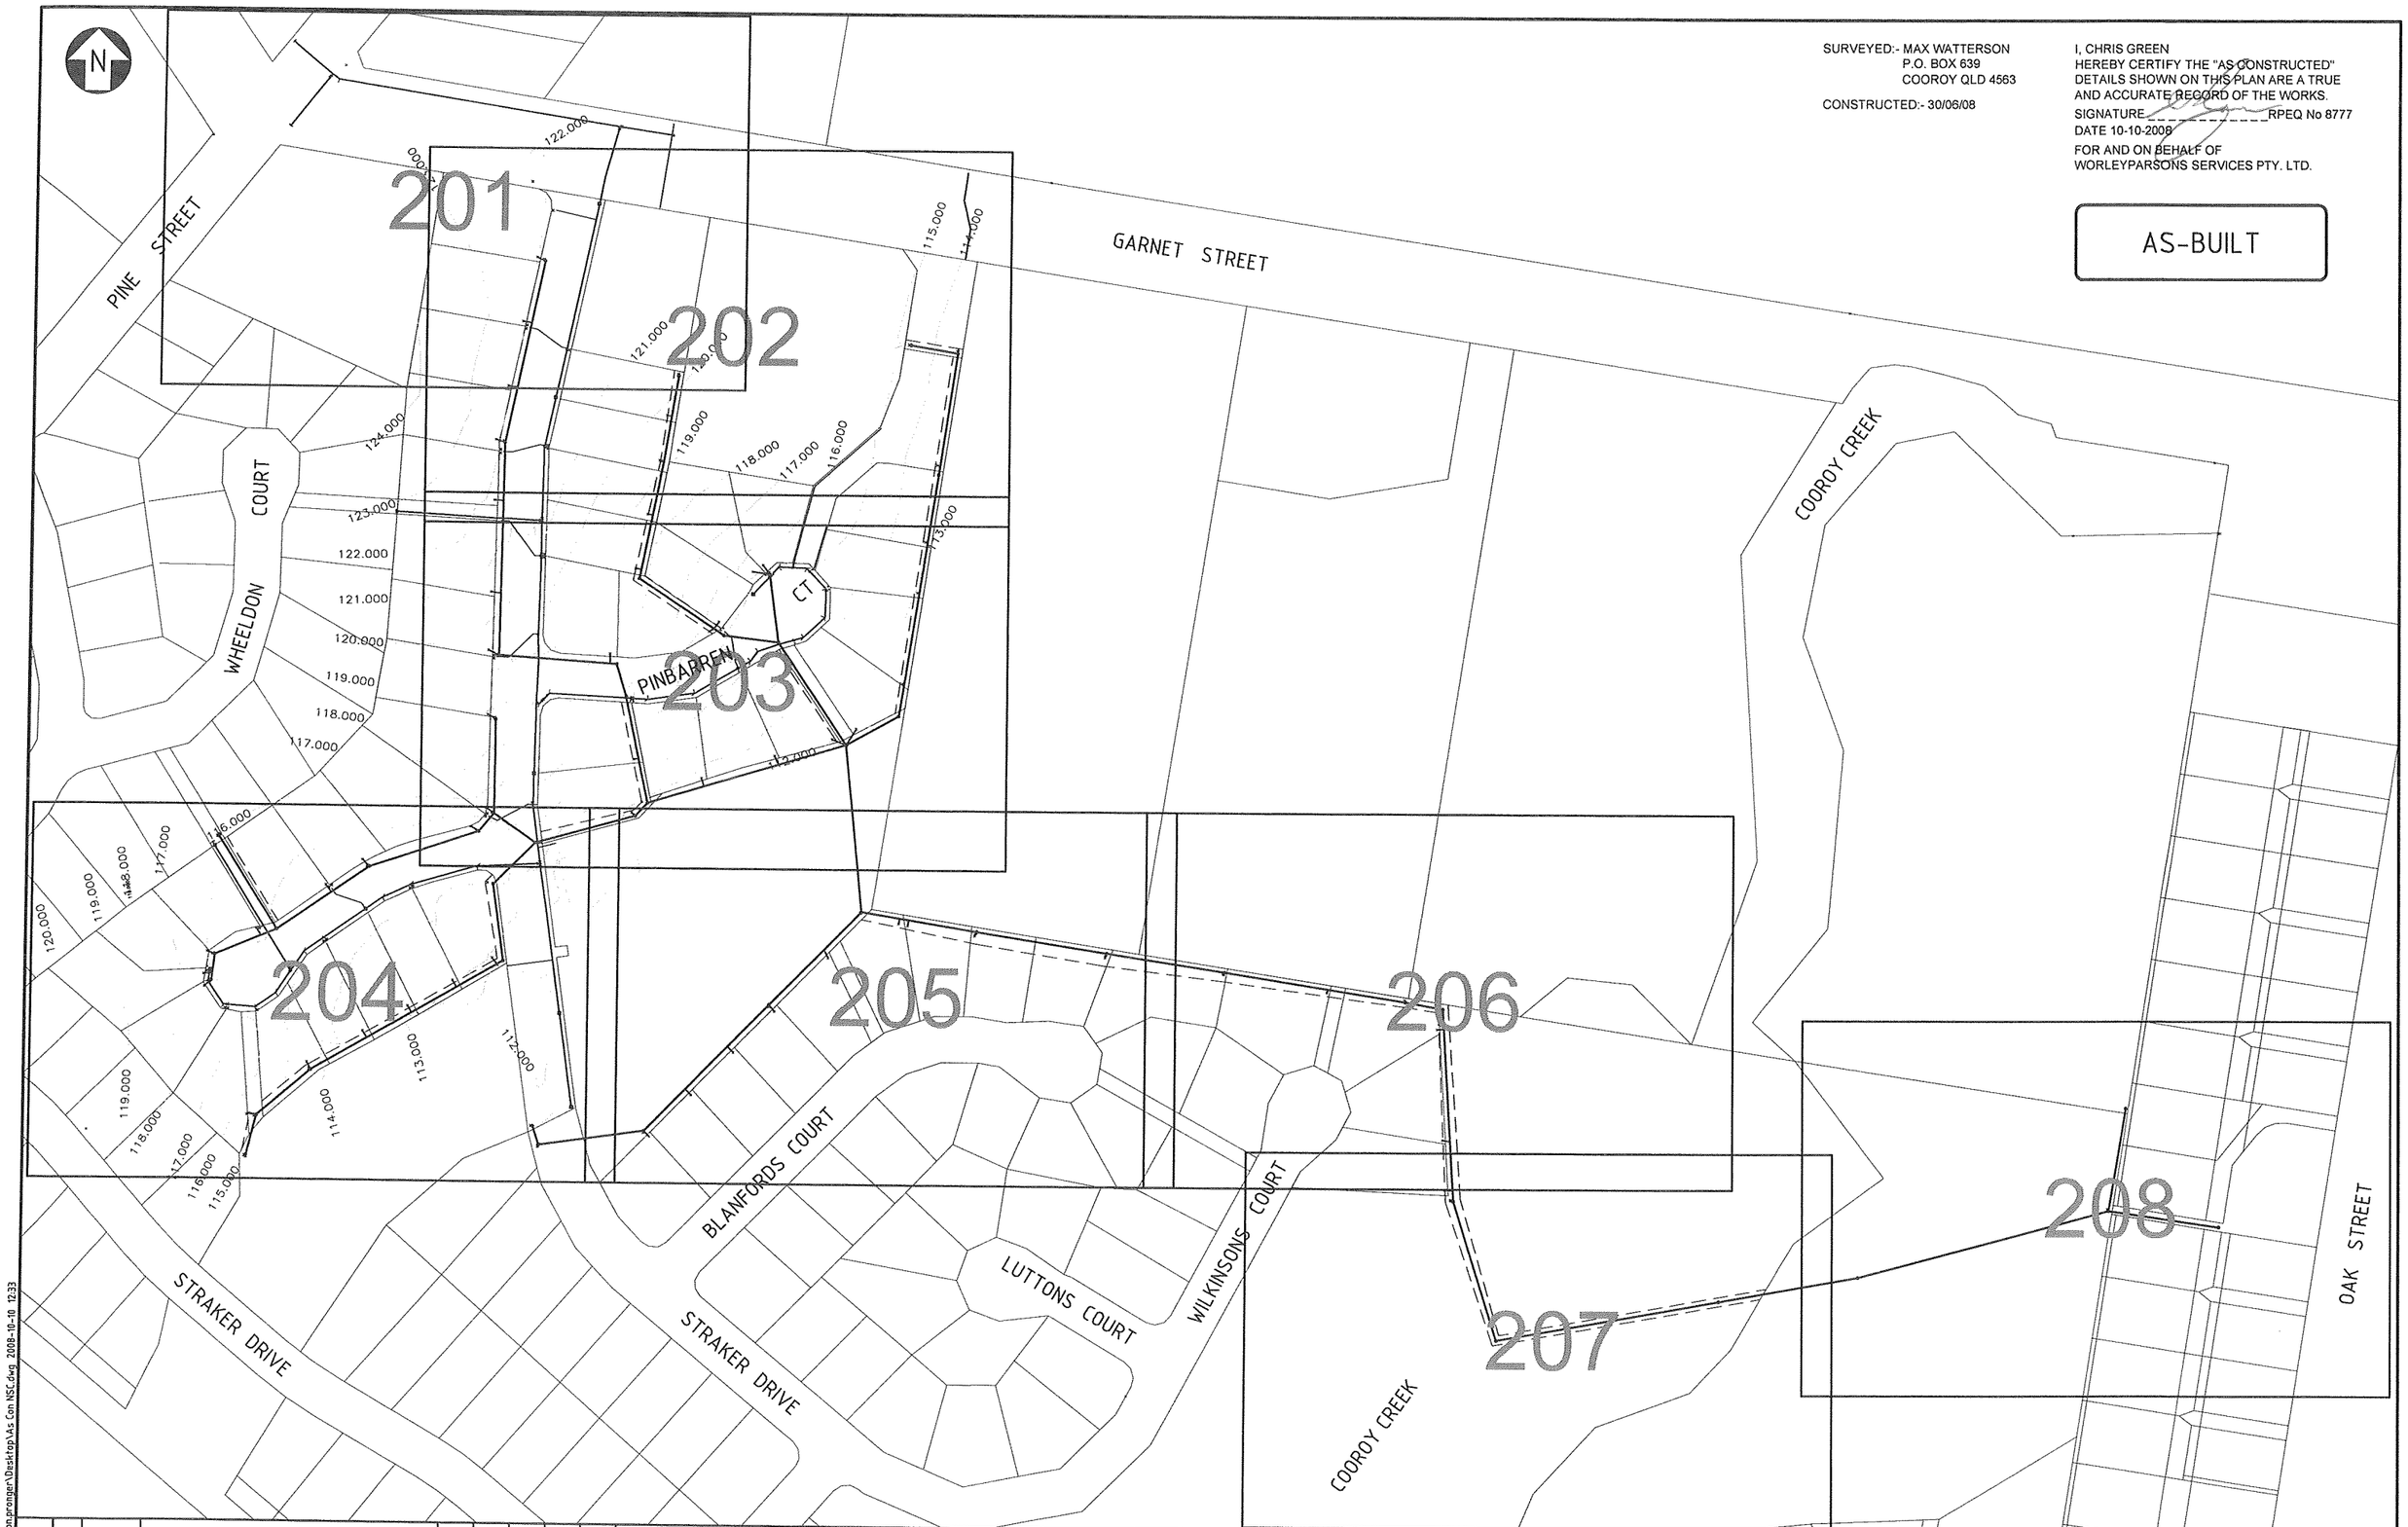

REV	DATE	REVISION DESCRIPTION	ORIG	CKD	ENG	QA	APPD	REF DRG NO	REFERENCE DRAWING TITLE
0	06/10/08	ISSUED FOR COUNCIL	DBG	CG	CG				
A	29/09/08	PRELIMINARY FOR APPROVAL	DBG	SJS	CG				

Copyright © WorleyParsons Services Pty Ltd ABN 61 001 279 812

A1 SHEET SCALE: 1:1000

Zero Harm — Leadership, No Incidents, Safe Behaviour

COORDINATES IN METRES UNO
ELEVATIONS IN METRES UNO
DIMENSIONS IN MILLIMETRES UNO

PREPARED FOR: PEET

WorleyParsons resources & energy

WORLEYPARSONS PROJECT NO: 1-070015-001

GREENWOOD GROVE
GARNET STREET, COOROY - STAGES 1 AND 2
AS CONSTRUCTED SEWER & WATER
SHEET KEY

DRAWING NO: 1-070015-200 REV: 0

C:\Documents and Settings\jon.prenger\Desktop\As Con NSC.dwg 2008-10-10 12:33

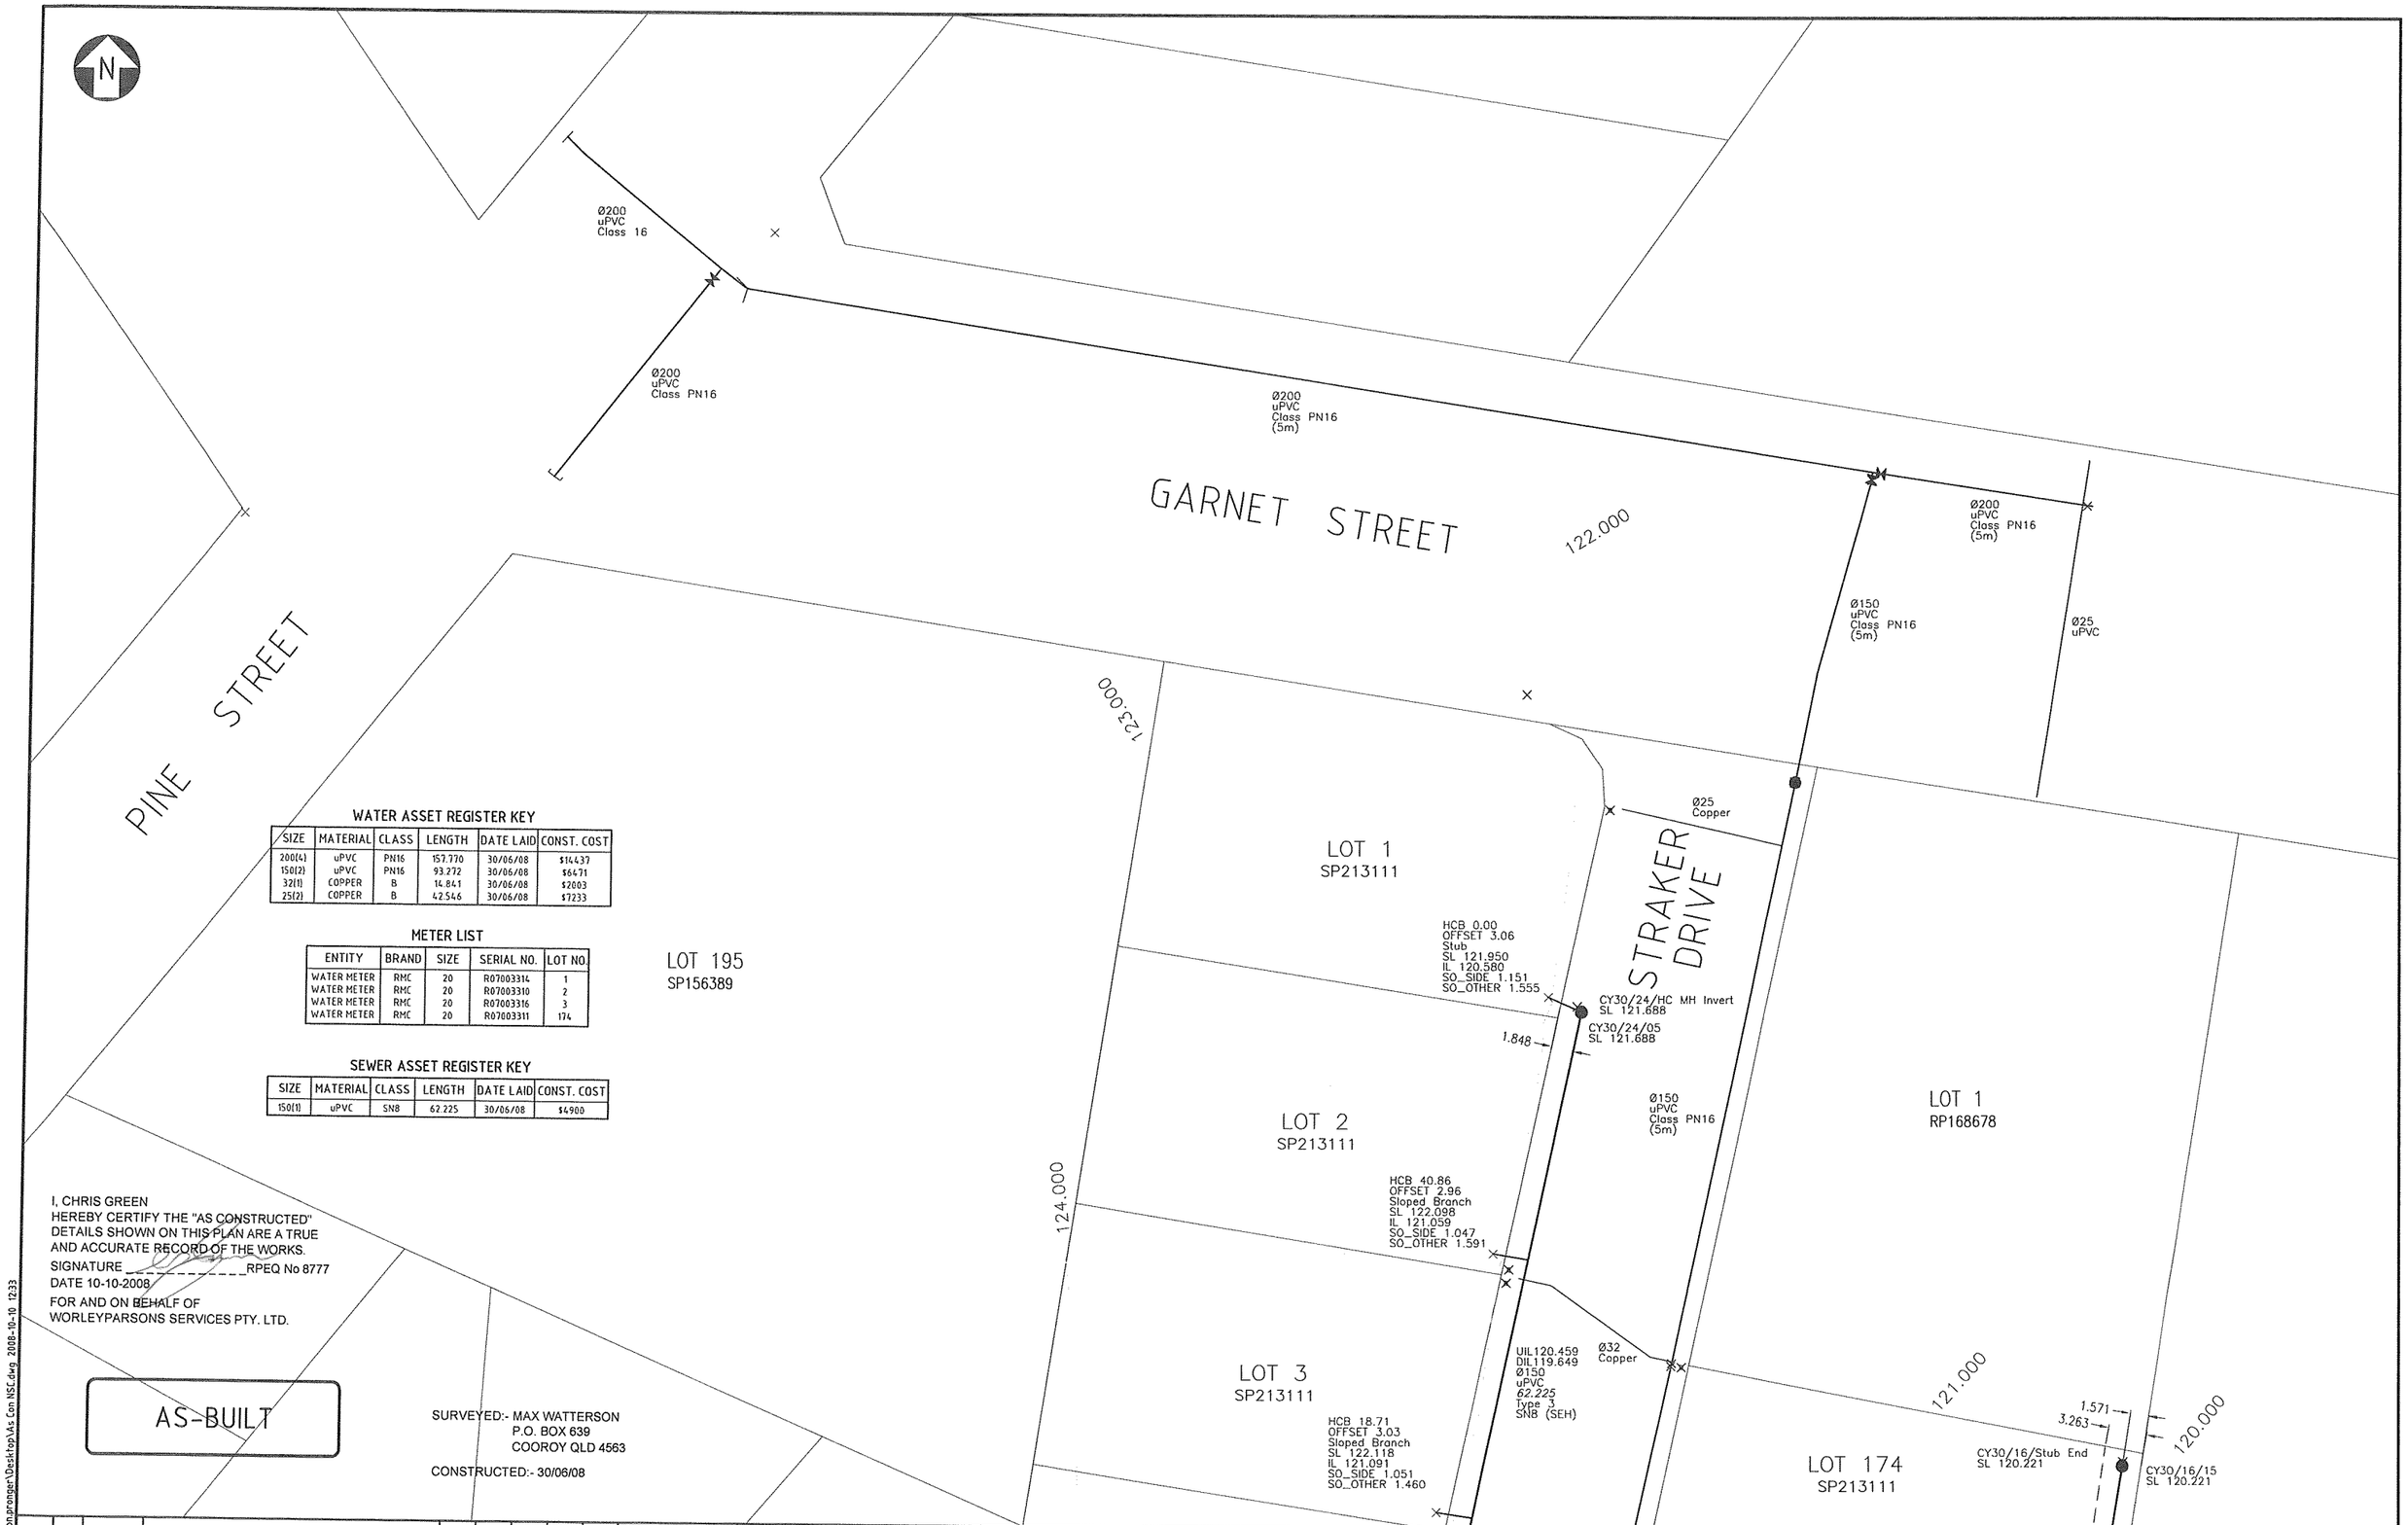

WATER ASSET REGISTER KEY

SIZE	MATERIAL	CLASS	LENGTH	DATE LAID	CONST. COST
200(4)	uPVC	PN16	157.770	30/06/08	$14437
150(2)	uPVC	PN16	93.272	30/06/08	$6471
32(1)	COPPER	B	14.841	30/06/08	$2003
25(2)	COPPER	B	42.546	30/06/08	$7233

METER LIST

ENTITY	BRAND	SIZE	SERIAL NO.	LOT NO.
WATER METER	RMC	20	R07003314	1
WATER METER	RMC	20	R07003310	2
WATER METER	RMC	20	R07003316	3
WATER METER	RMC	20	R07003311	174

SEWER ASSET REGISTER KEY

SIZE	MATERIAL	CLASS	LENGTH	DATE LAID	CONST. COST
150(1)	uPVC	SN8	62.225	30/06/08	$4900

I, CHRIS GREEN
HEREBY CERTIFY THE "AS CONSTRUCTED"
DETAILS SHOWN ON THIS PLAN ARE A TRUE
AND ACCURATE RECORD OF THE WORKS.
SIGNATURE _____ RPEQ No 8777
DATE 10-10-2008
FOR AND ON BEHALF OF
WORLEYPARSONS SERVICES PTY. LTD.

AS-BUILT

SURVEYED:- MAX WATTERSON
P.O. BOX 639
COOROY QLD 4563

CONSTRUCTED:- 30/06/08

REV	DATE	REVISION DESCRIPTION	ORIG	CKD	ENG	QA	APPD	REF DRG NO	REFERENCE DRAWING TITLE
0	06/10/08	ISSUED FOR COUNCIL	DBG	CG	CG				
A	29/09/08	PRELIMINARY FOR APPROVAL	DBG	SJS	CG				

Copyright © WorleyParsons Services Pty Ltd ABN 61 001 279 812

C:\Documents and Settings\jongranger\Desktop\As Con NSC.dwg 2008-10-10 12:33

A1 SHEET SCALE: 1:250

Zero Harm — Leadership, No Incidents, Safe Behaviour

COORDINATES IN METRES UNO
ELEVATIONS IN METRES UNO
DIMENSIONS IN MILLIMETRES UNO

PREPARED FOR: PEET

WorleyParsons resources & energy

WORLEYPARSONS PROJECT NO: 1-070015-001

GREENWOOD GROVE
GARNET STREET, COOROY - STAGES 1 AND 2
AS CONSTRUCTED SEWER & WATER
SHEET 1 OF 8

DRAWING NO: 1-070015-201 REV: 0

SURVEYED:- MAX WATTERSON
P.O. BOX 639
COOROY QLD 4563

CONSTRUCTED:- 30/06/08

I, CHRIS GREEN
HEREBY CERTIFY THE "AS CONSTRUCTED"
DETAILS SHOWN ON THIS PLAN ARE A TRUE
AND ACCURATE RECORD OF THE WORKS.
SIGNATURE _____ RPEQ No 8777
DATE 10-10-2008
FOR AND ON BEHALF OF
WORLEYPARSONS SERVICES PTY. LTD.

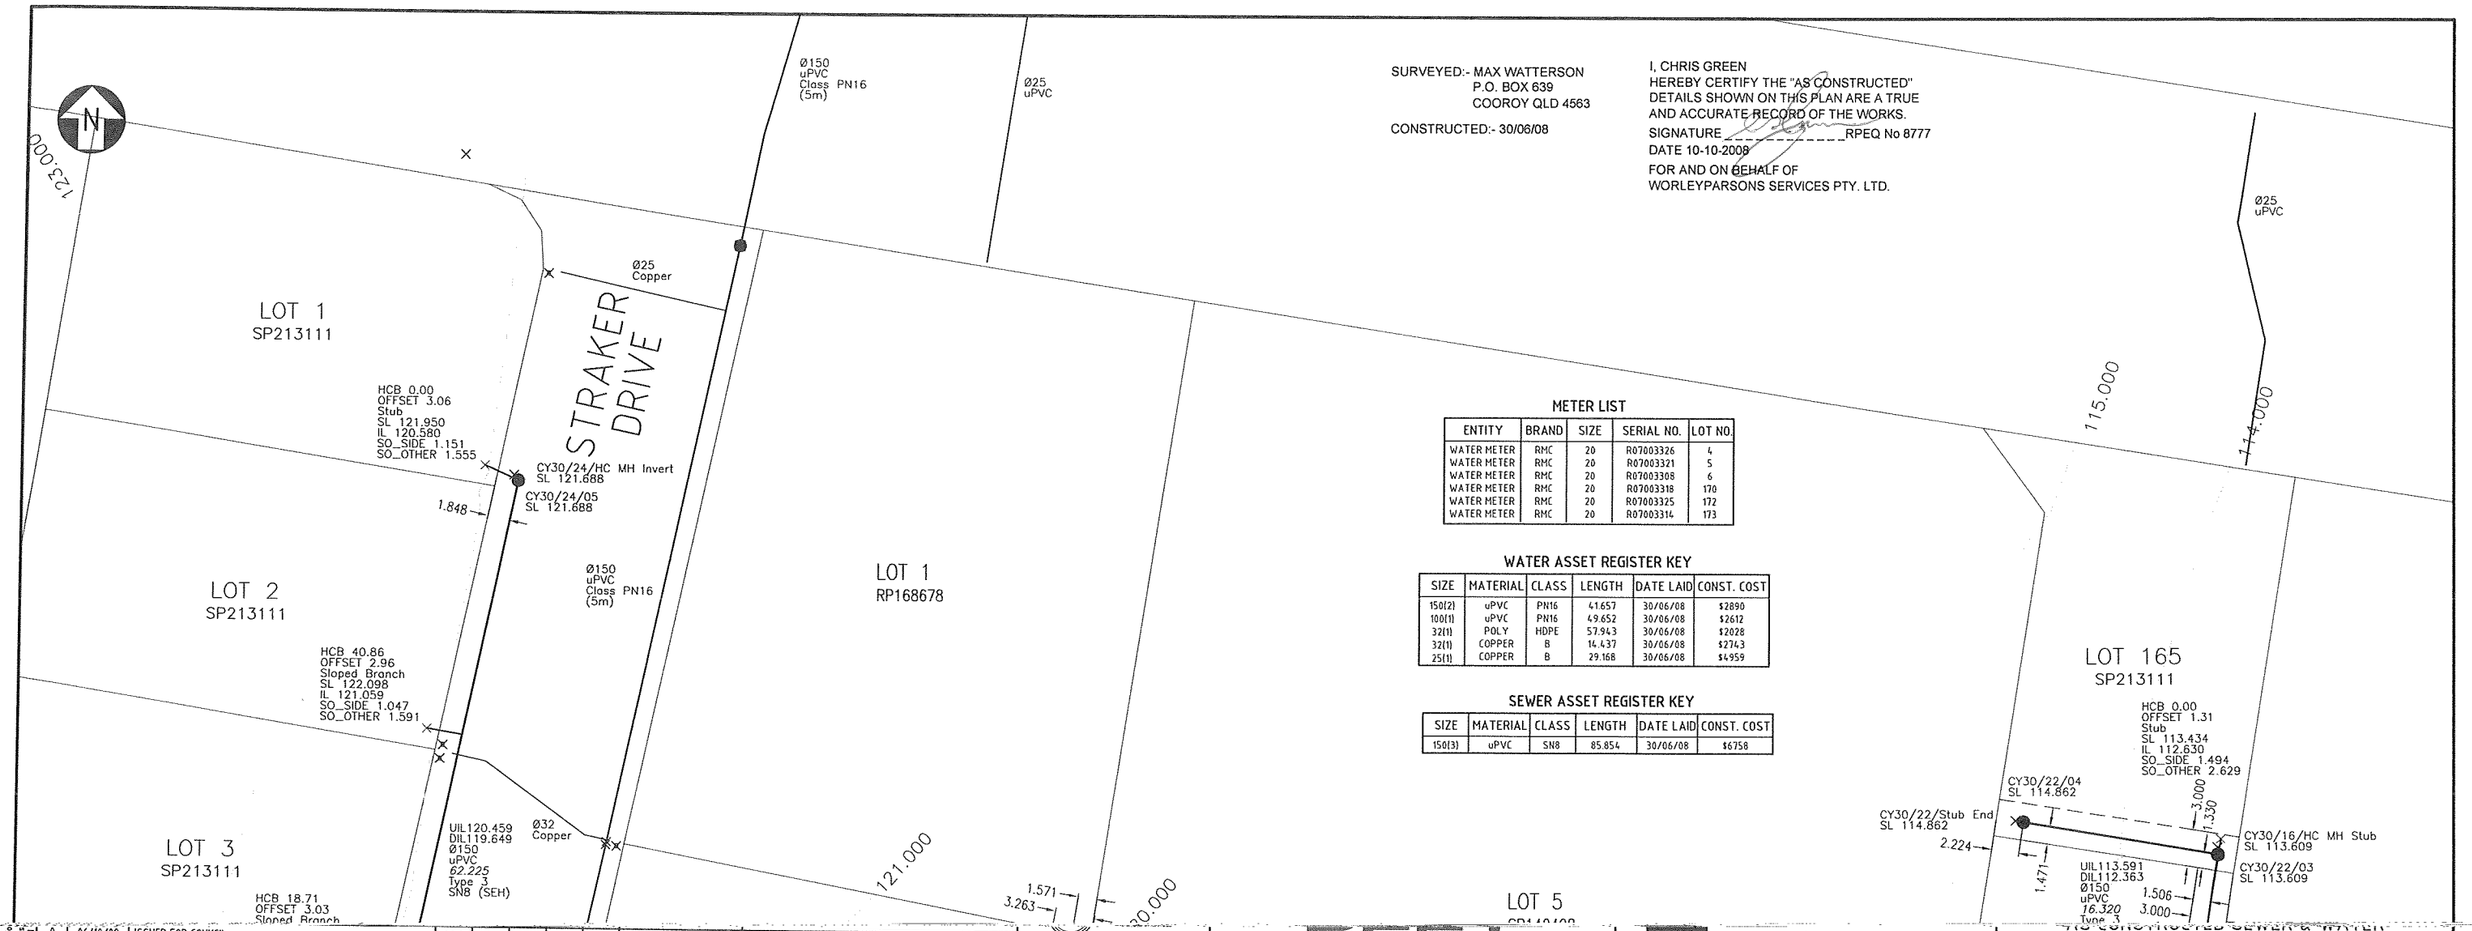

METER LIST

ENTITY	BRAND	SIZE	SERIAL NO.	LOT NO.
WATER METER	RMC	20	R07003326	4
WATER METER	RMC	20	R07003321	5
WATER METER	RMC	20	R07003308	6
WATER METER	RMC	20	R07003318	170
WATER METER	RMC	20	R07003325	172
WATER METER	RMC	20	R07003314	173

WATER ASSET REGISTER KEY

SIZE	MATERIAL	CLASS	LENGTH	DATE LAID	CONST. COST
150(2)	uPVC	PN16	41.657	30/06/08	$2890
100(1)	uPVC	PN16	49.652	30/06/08	$2612
32(1)	POLY	HDPE	57.943	30/06/08	$2028
32(1)	COPPER	B	14.437	30/06/08	$2743
25(1)	COPPER	B	29.168	30/06/08	$4959

SEWER ASSET REGISTER KEY

SIZE	MATERIAL	CLASS	LENGTH	DATE LAID	CONST. COST
150(3)	uPVC	SN8	85.854	30/06/08	$6758

REV	DATE	REVISION DESCRIPTION	ORIG	CKD	ENG	QA	APPD	REF DRG NO	REFERENCE DRAWING TITLE
0	06/10/08	ISSUED FOR COUNCIL	DBG	CG	CG				
A	29/09/08	PRELIMINARY FOR APPROVAL	DBG	SJS	CG				

COORDINATES IN METRES UNO
ELEVATIONS IN METRES UNO
DIMENSIONS IN MILLIMETRES UNO

PEET

WorleyParsons resources & energy

WORLEYPARSONS PROJECT NO: 1-070015-001

AS CONSTRUCTED SEWER & WATER
SHEET 7 OF 8

DRAWING NO: 1-070015-207 REV: 0

C:\Documents and Settings\jon.prangen\Desktop\As Con NSE.dwg 2008-10-10 12:33
Copyright © WorleyParsons Services Pty Ltd ABN 61 001 279 812

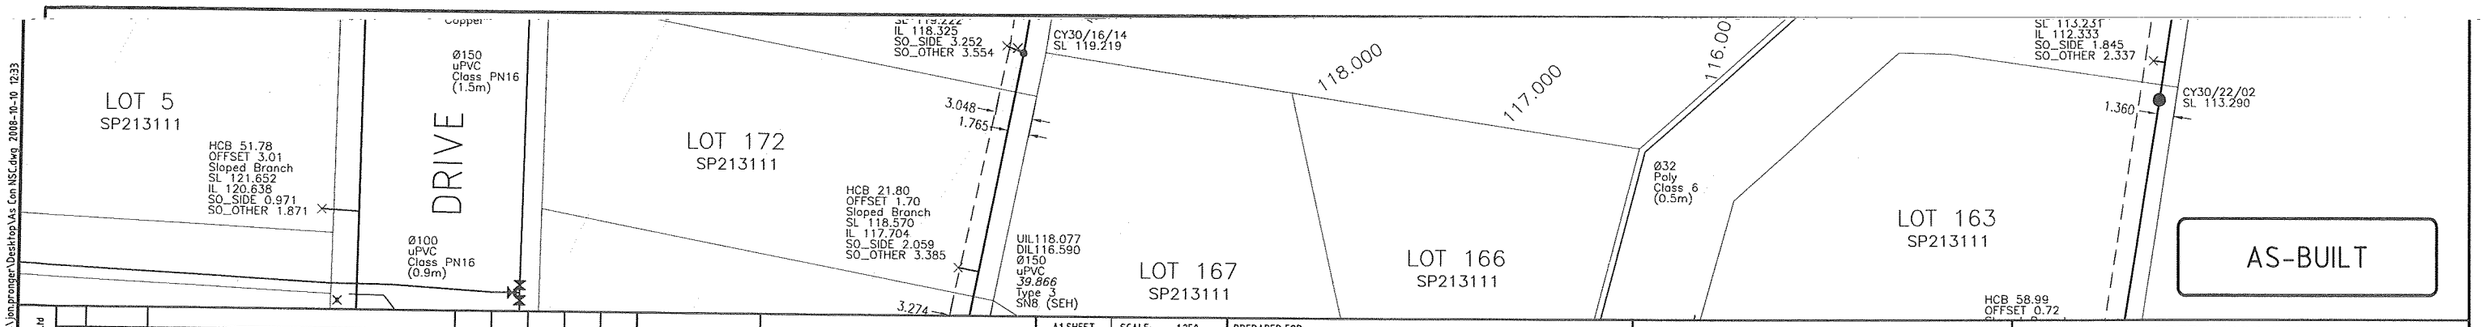

AS-BUILT

REV	DATE	REVISION DESCRIPTION	ORIG	CKD	ENG	QA	APPD	REF DRG NO	REFERENCE DRAWING TITLE
0	06/10/08	ISSUED FOR COUNCIL	DBG	CG	CG				
A	29/09/08	PRELIMINARY FOR APPROVAL	DBG	SJS	CG				

A1 SHEET SCALE: 1:250

Zero Harm — Leadership, No Incidents, Safe Behaviour

COORDINATES IN METRES UNO
ELEVATIONS IN METRES UNO
DIMENSIONS IN MILLIMETRES UNO

PREPARED FOR: PEET

WorleyParsons resources & energy

WORLEYPARSONS PROJECT NO: 1-070015-001

GREENWOOD GROVE
GARNET STREET, COOROY - STAGES 1 AND 2
AS CONSTRUCTED SEWER & WATER
SHEET 2 OF 8

DRAWING NO: 1-070015-202 REV: 0

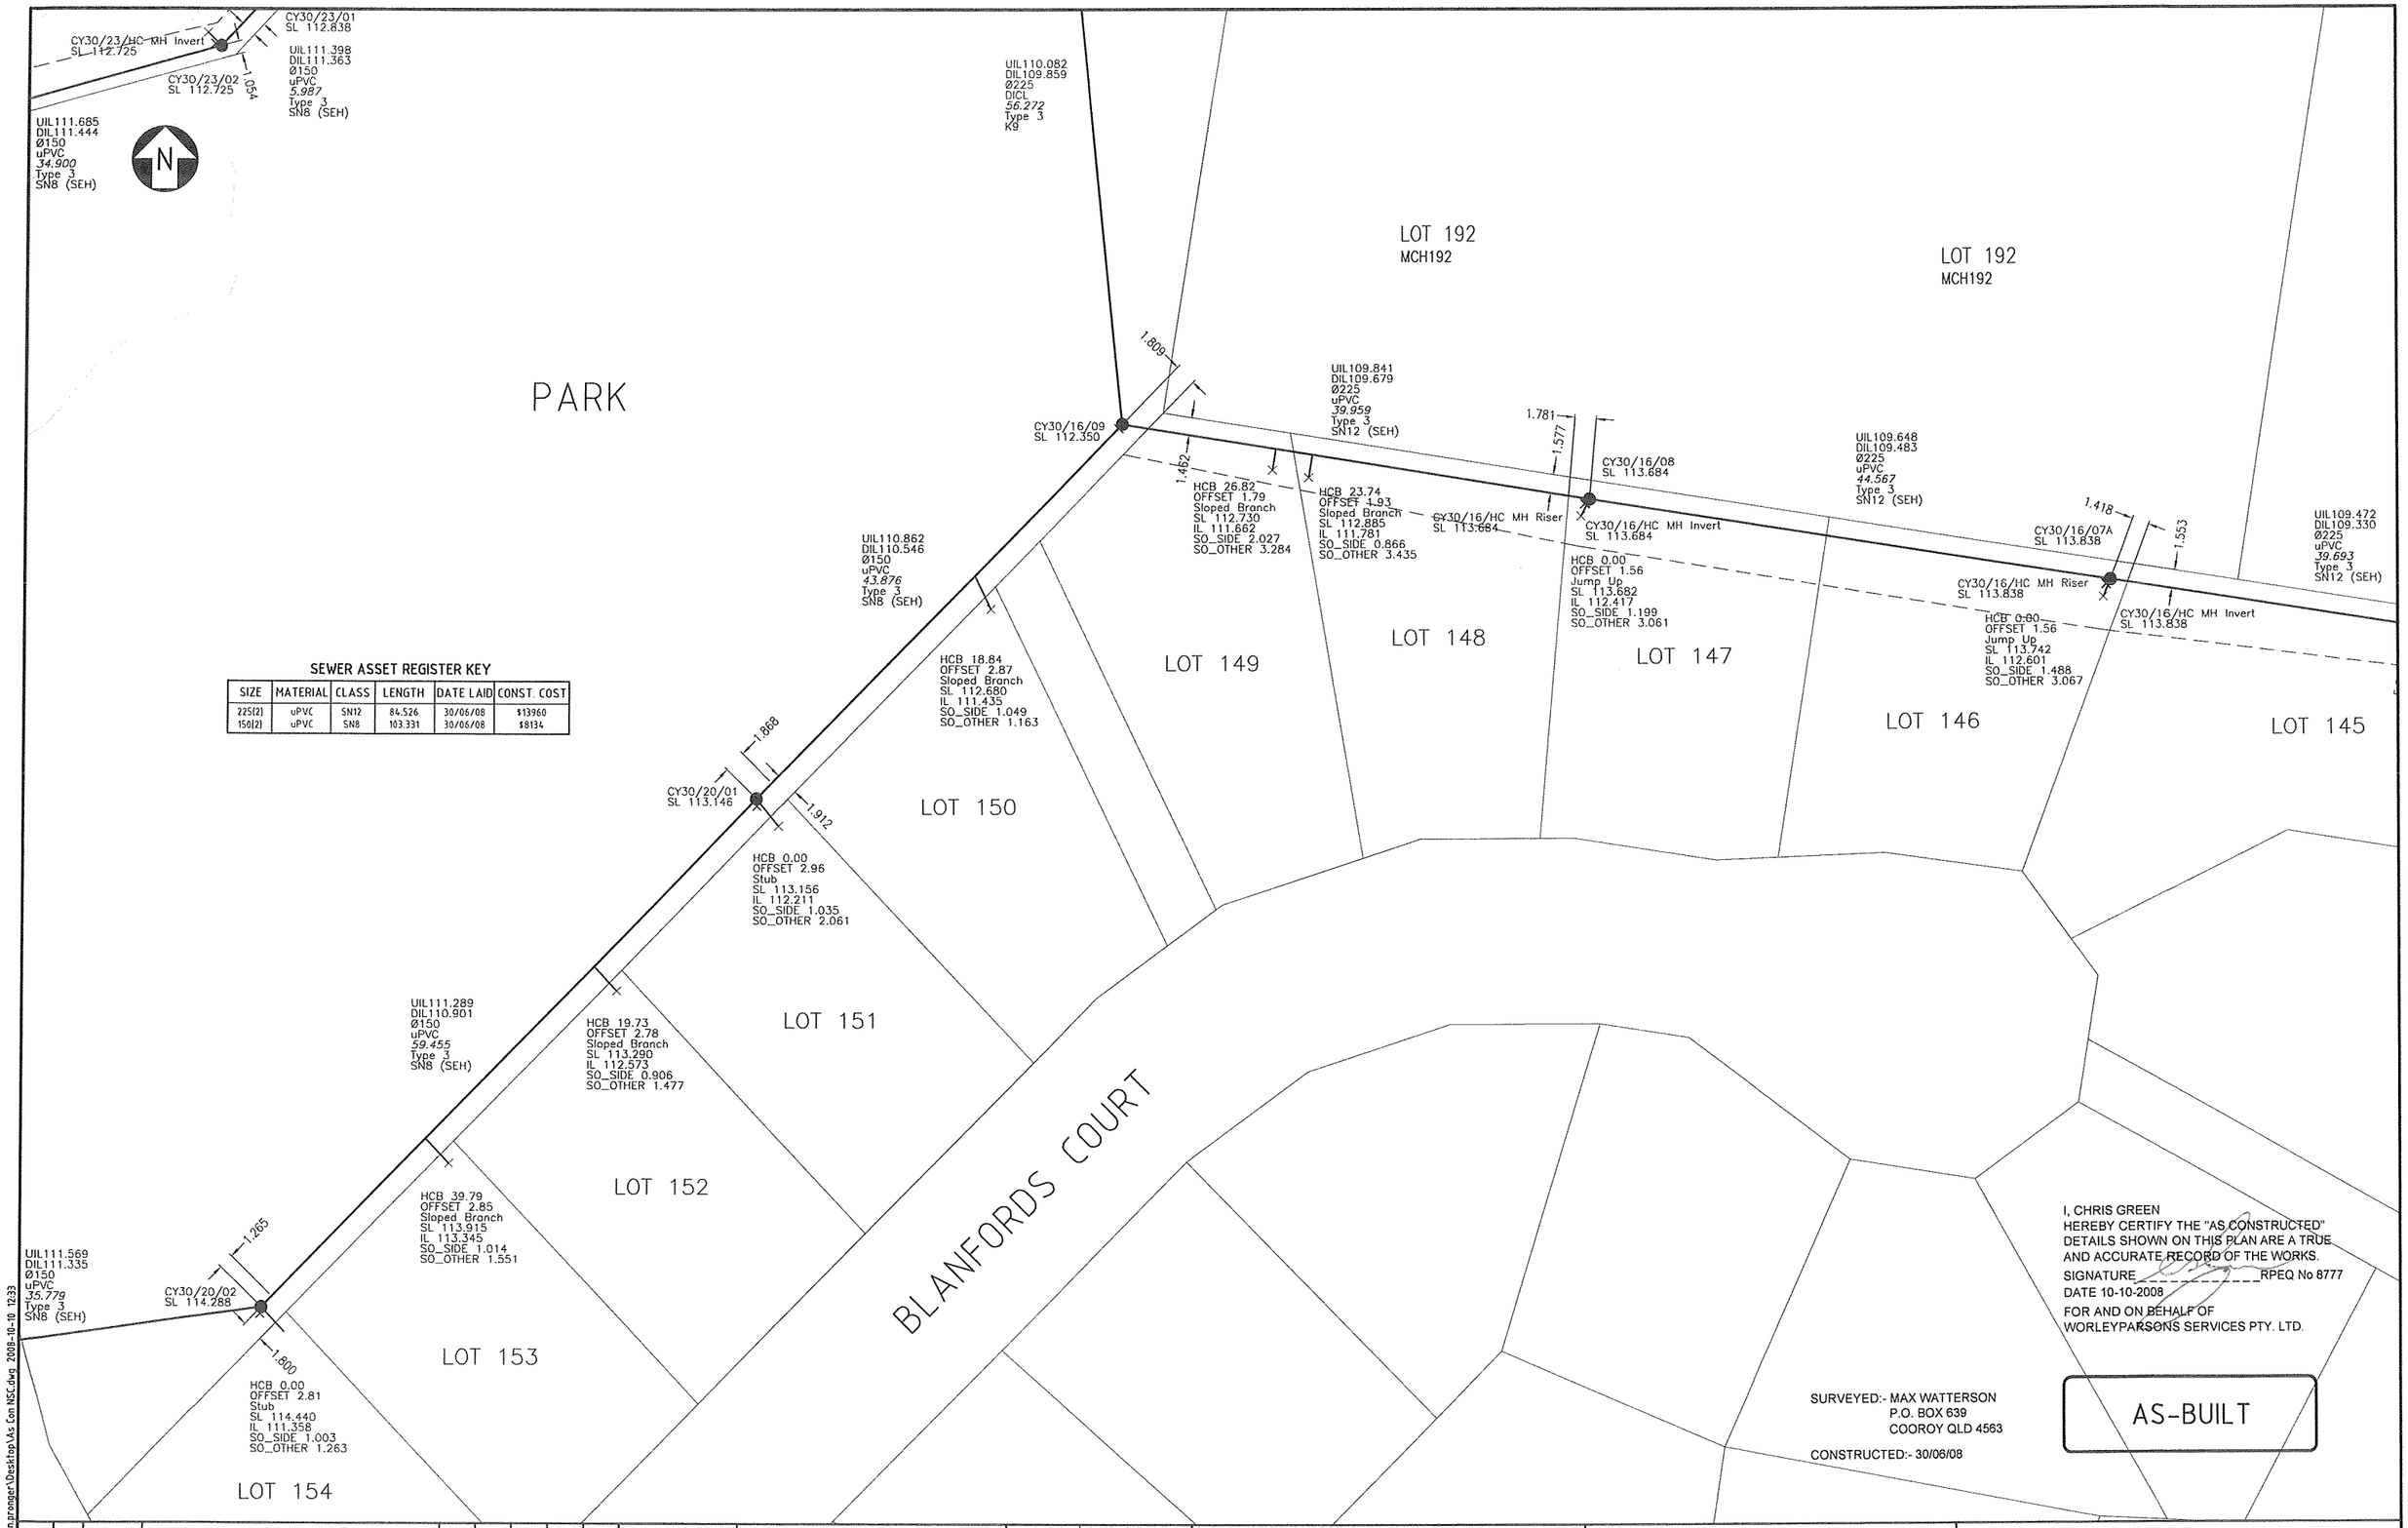

SEWER ASSET REGISTER KEY

SIZE	MATERIAL	CLASS	LENGTH	DATE LAID	CONST. COST
225(2)	uPVC	SN12	84.526	30/06/08	$13960
150(2)	uPVC	SN8	103.331	30/06/08	$8134

REV	DATE	REVISION DESCRIPTION	ORIG	CKD	ENG	QA	APPD	REF DRG NO	REFERENCE DRAWING TITLE
0	06/10/08	ISSUED FOR COUNCIL	DBG	CG	CG				
A	29/09/08	PRELIMINARY FOR APPROVAL	DBG	SJS	CG				

A1 SHEET | SCALE: 1:250

Zero Harm — Leadership, No Incidents, Safe Behaviour

COORDINATES IN METRES UNO
ELEVATIONS IN METRES UNO
DIMENSIONS IN MILLIMETRES UNO

PREPARED FOR: PEET

WorleyParsons resources & energy

WORLEYPARSONS PROJECT NO: 1-070015-001

GREENWOOD GROVE
GARNET STREET, COOROY - STAGES 1 AND 2
AS CONSTRUCTED SEWER & WATER
SHEET 5 OF 8

DRAWING NO: 1-070015-205 REV: 0

Copyright © WorleyParsons Services Pty Ltd ABN 61 001 279 812

C:\Documents and Settings\jon.pronger\Desktop\As Con NSC.dwg 2008-10-10 12:33

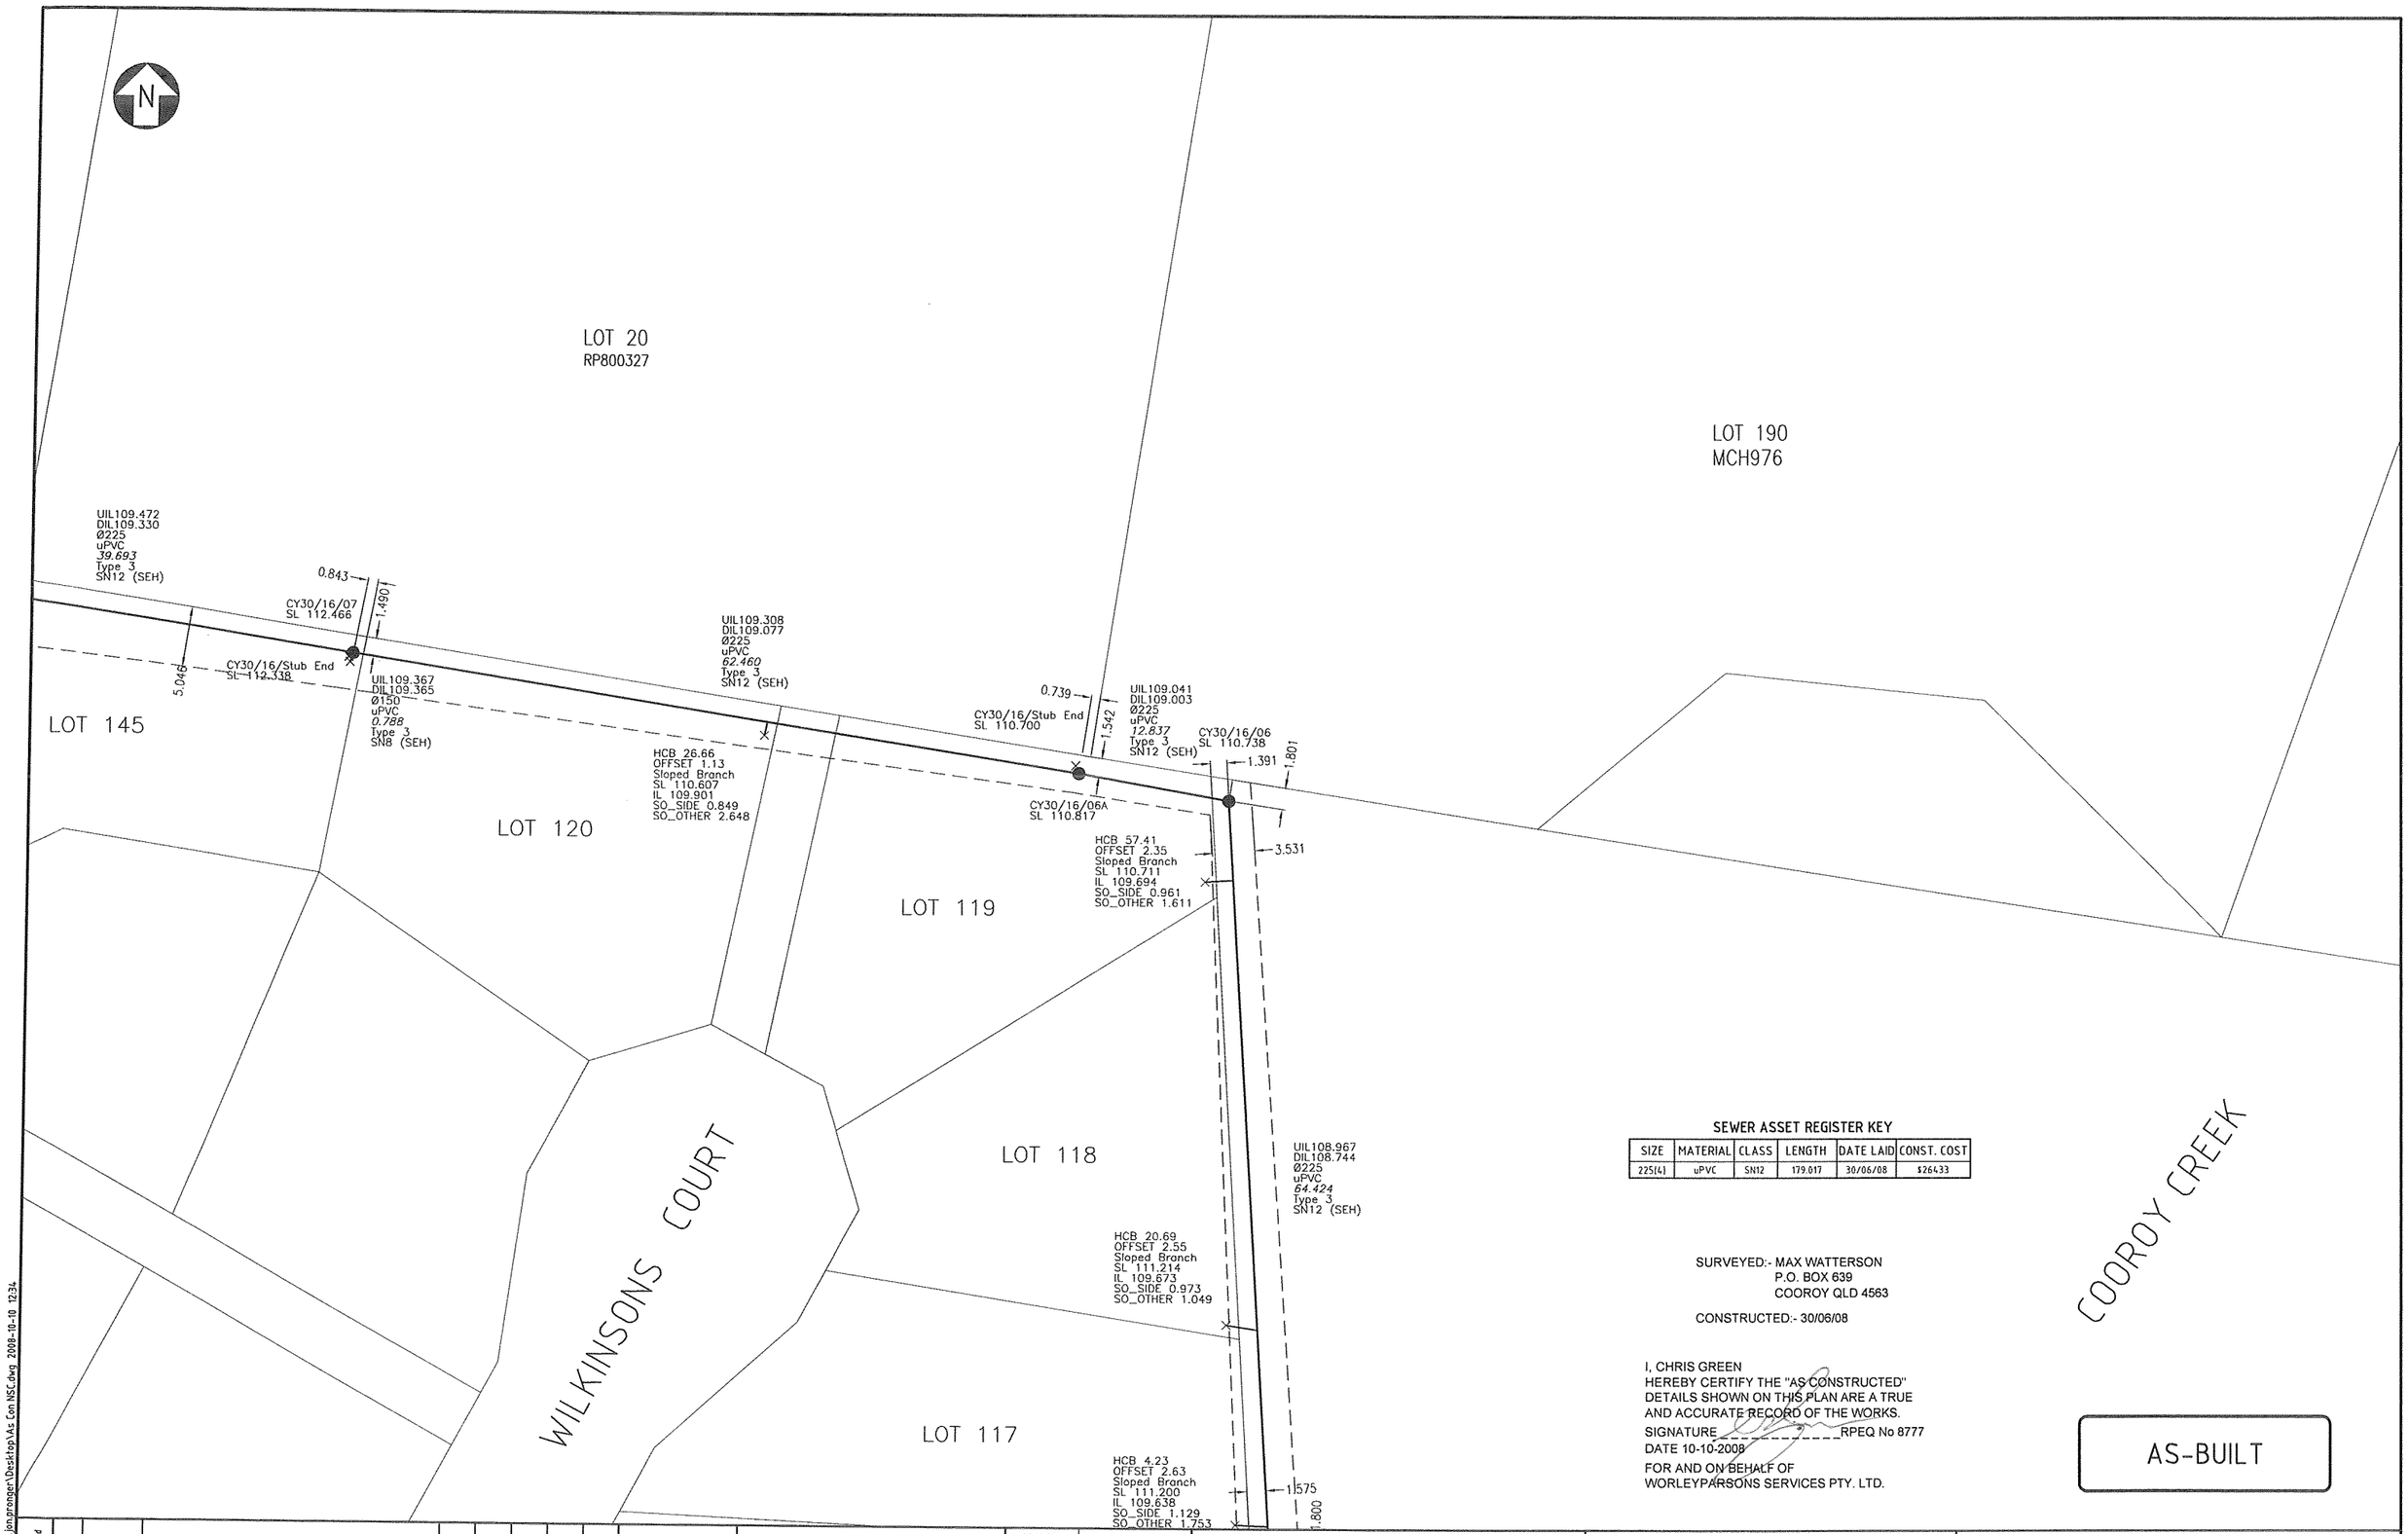

SEWER ASSET REGISTER KEY

SIZE	MATERIAL	CLASS	LENGTH	DATE LAID	CONST. COST
225(4)	uPVC	SN12	179.017	30/06/08	$26433

SURVEYED:- MAX WATTERSON
P.O. BOX 639
COOROY QLD 4563

CONSTRUCTED:- 30/06/08

I, CHRIS GREEN
HEREBY CERTIFY THE "AS CONSTRUCTED"
DETAILS SHOWN ON THIS PLAN ARE A TRUE
AND ACCURATE RECORD OF THE WORKS.
SIGNATURE _____ RPEQ No 8777
DATE 10-10-2008
FOR AND ON BEHALF OF
WORLEYPARSONS SERVICES PTY. LTD.

AS-BUILT

REV	DATE	REVISION DESCRIPTION	ORIG	CKD	ENG	QA	APPD	REF DRG NO	REFERENCE DRAWING TITLE
0	06/10/08	ISSUED FOR COUNCIL	DBG	CG	CG				
A	29/09/08	PRELIMINARY FOR APPROVAL	DBG	SJS	CG				

Copyright © WorleyParsons Services Pty Ltd ABN 61 001 279 812

A1 SHEET | SCALE: 1:250

Zero Harm — Leadership, No Incidents, Safe Behaviour

COORDINATES IN METRES UNO
ELEVATIONS IN METRES UNO
DIMENSIONS IN MILLIMETRES UNO

PREPARED FOR: PEET

WorleyParsons resources & energy

WORLEYPARSONS PROJECT NO: 1-070015-001

GREENWOOD GROVE
GARNET STREET, COOROY - STAGES 1 AND 2
AS CONSTRUCTED SEWER & WATER
SHEET 6 OF 8

DRAWING NO: 1-070015-206 REV: 0

C:\Documents and Settings\jon.prongen\Desktop\As Con NSC.dwg 2008-10-10 12:34